


Section 27 Township 8 Range 22W

Well No. #1 Mickleson

Company Jones, Shelburne & Farmer

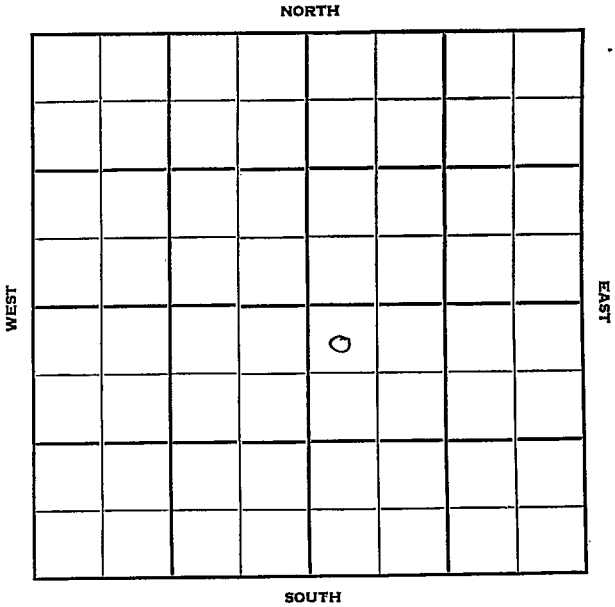

27

8

22W

Sec. _____ Twp. _____ R. _____

#1 Mickleson

Well No. _____ Farm _____

Jones, Shelburne & Farmer

Company _____

Jones, Shelburne & Farmer

Contractor _____

330

Wildcat


Ft. from N. Line _____

Ft. from S. Line _____

Ft. from E. Line _____

330 Ft. from W. Line _____

NW NW SE

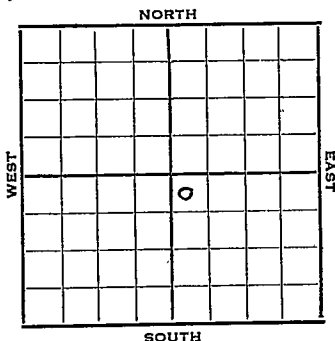

1952

Elev. 2176'

REPORT

8/20

Location

8/27

"

9/3

8" @ 133'

9/10

Anhy 1779'

Drlg. 3248'

9/17

Heeb. 3381', Lans. 3422'

DST 3449-64, 1 hr, 365' SW 1250# 15"

DST 3481-3514, 1 hr, 60' HOCM, 155'

muddy oil, 40' free oil, 540' gas, 1180# 15".

Marm 3697' Cong. 3743' Arb. 3759'

RTD 3775' 5" @ 3762'

DST 3762-75, 1 hr, 90' HO & GCM, 178'

muddy oil, 960# 15". Schl

9/24

CO 3775' B/2 BOPH 500 A

S/6½ BOPH

10/1

P/7 BOPH for 8 hrs.

10/8

Spud 9-2-52

Oil Well TD 3775'

8" @ 133'

Anhy 1779

Heeb. 3381

Lans. 3422

DST 3449-64 open 1 hr. rec. 365'

SW

DST 3481-3514 open 1 hr. rec. 60'


HOCM 155' muddy oil 40' free oil

OVER

1952

10/8 540' gas 1180#
Sō 3543-48 Marm. 3697 Cong. 3743
Arb. 3759
TD 3775 5" @ 3762
DST 3762-75 open 1 hr. rec. 90'
O&GCM 178' muddy oil 960#
CO to 3775' B/ 2 boph 500 A
S/ $6\frac{1}{2}$ boph P/ 7 boph
Comp. 278 bopd

COMPLETED

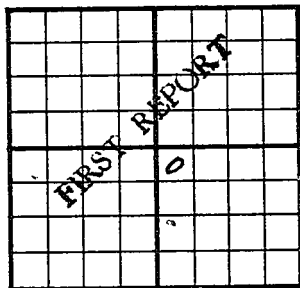County Graham State KansasSec. 27 (Blk. Twp.) 8 (Sur. Rge.) 22W Map No.Operator Jones, Shelburne & FarmerWell No. 1 Farm NicklesonElev. Location NW NW SE330 Ft. From N Line SE330 Ft. From W Line Quarter1st. Report AUG 20 1952

Completion

Remarks

Jones, Shelburne & Farmer-Contr

Spudding Date

Drlg. Data WildcatLocation

J. G. McGEHEE

