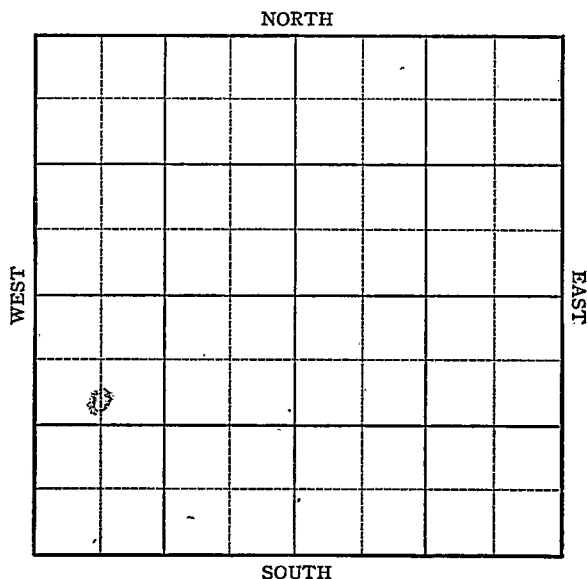


KANSAS

Rooks county

Section 27 Township 8 Range 19-WWell No. #3, VerverkaCompany Bird and Boreing

Rooks county ✓

Sec. 27 **KANSAS** Twp. 8 R. 19-W

Well No. #3, Ververka Farm

Bird and Boreing Company

Ververka Pool


990' Ft. from N. Line

 Ft. from S. Line

 Ft. from E. Line

660' Ft. from W. Line

C S L NW SW

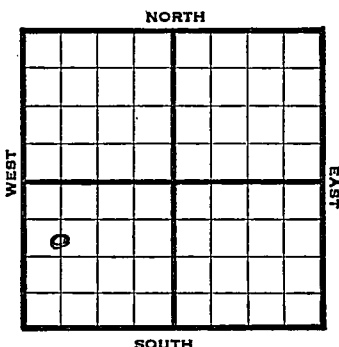

1946

REPORT

10/30 Location.

11/6

11/13 Location Abandoned

ABANDONED

Ververka Pool

Form 26 200 Bks. 10-46 Petrol

Map No. 65 Sec. 27 Twp. 8 R. 19W

Well No. 3 Ververka

Bird & Boreing Company

FIRST REPORT Contractor

C S L NW SW

SECTION PLAT

990 Ft. from N. Line

Ft. from S. Line

Ft. from E. Line

660 Ft. from W. Line

Rooks County

Location X

Rig up

Drilling and Remarks:

RECORD

Cased in., ft.

Sand

Gas

Oil

Total Depth

PRODUCTION

1st 24 hrs. Nat.

1st 24 hrs. after shot

Gas Cu. Ft.

Dry Hole

Abandoned

Date

OCT 30 1946 19

S. J. LEWIS Scout

Map No. 65 Sec. 27 Twp. 8 R. 19W

Kansas

Well No. 3 Ververka

Bird & Boreing

Company

ABANDONED

Contractor

C S L NW SW

SECTION PLAT

990 Ft. from N. Line Ft. from S. Line Ft. from E. Line660 Ft. from W. Line

Rooks County

Location ✓Rig up Drilling and Remarks:

RECORD

Cased in., ft.Sand Gas Oil Total Depth

PRODUCTION

1st 24 hrs. Nat. 1st 24 hrs. after shot Gas Cu. Ft.Dry Hole Abandoned

Date

NOV 13 1946 19

S. J. LEWIS

Scout