


Section 27 Township 8 Range 39-W

Well No. #1 Wilcoxon

Company Goodland Independent Gas

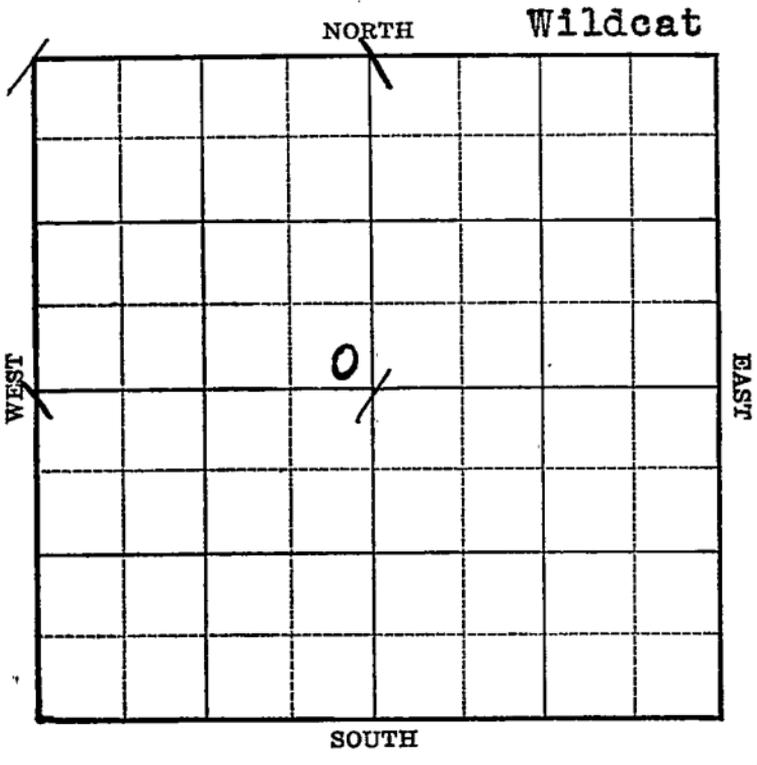

Sec. 27 Twp. 8 R. 39W

Well No. #1 Wilcoxon Farm \_\_\_\_\_  
Goodland Independent Gas Company


Wildcat

\_\_\_\_\_ Ft. from N. Line

100 Ft. from S. Line

100 Ft. from E. Line

\_\_\_\_\_ Ft. from W. Line

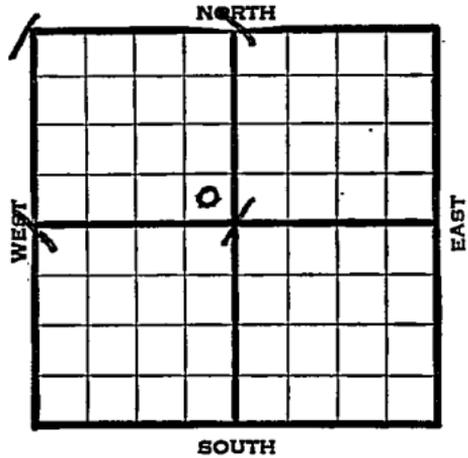

Elev. 3642

1939	REPORT
6/7	7" 700 DLg. 806
6/16	No report.
6/23	Lime 986' Show gas 716'
	T.D. 1100' Estimated 25 to 30,000 gas.
6/29	No report.
7/6	Shut down.
7/13	" "
7/20	" "
7/27	" "
8/3	" "
8/10	" "
8/17	" "
8/24	" "
8/30	Lime 986'
	Gas 716'
	T.D. 1100'
	25,000 cu. ft. gas.
	<b>COMPLETED</b>

**KANSAS**

**Sherman**

Map No. MM Sec. 27 Twp. 8 R. 39W

Well No. 1 Wilcoxon


Goodland Independent Gas Company

Contractor

**FIRST REPORT**

**SECTION PLAT**

**SE NW**

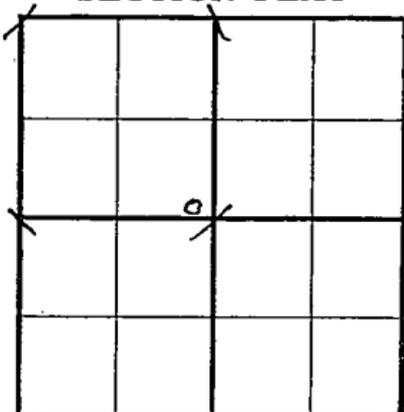

         Ft. from N. Line

100 Ft. from S. Line

100 Ft. from E. Line

         Ft. from W. Line

**WILDCAT**

Location                                 

Rig up                                 

Drilling and Remarks:

**7" @ 700**

**Drlg 806**

**RECORD**

Cased          in.,          ft.

Sand                                 

Gas                                 

Oil                                 

Total Depth                         

**PRODUCTION**

1st 24 hrs. Nat.                         

1st 24 hrs. after shot                         

Gas                                  Cu. Ft.

Dry Hole                                 

Abandoned                                 

Date

**JUN 7 1939** 19

**S. J. LEWIS**

Scout

Map No. NM Sec. 27 Twp. 8 R. 39W

Well No. 1 Wilcox

Goodland Independent <sup>Gas</sup> Company


Contractor

*SE NW*

**COMPLETED**

\_\_\_\_\_ Ft. from N. Line  
100 Ft. from S. Line  
100 Ft. from E. Line  
 \_\_\_\_\_ Ft. from W. Line

**SECTION PLAT**

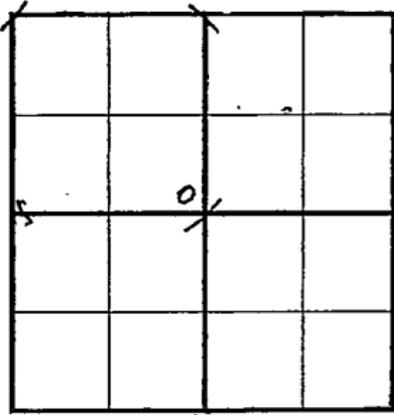

*Wild Cat*

Location \_\_\_\_\_

Rig up \_\_\_\_\_

Drilling and Remarks:

*Line 986*

*Gas 716*

*25,000 cu ft.  
gas.*

**RECORD**

Cased \_\_\_\_\_ in., \_\_\_\_\_ ft.

Sand \_\_\_\_\_

Gas \_\_\_\_\_

Oil \_\_\_\_\_

Total Depth 1100

**PRODUCTION**

1st 24 hrs. Nat. \_\_\_\_\_

1st 24 hrs. after shot \_\_\_\_\_

Gas \_\_\_\_\_ Cu. Ft.

Dry Hole \_\_\_\_\_

Abandoned \_\_\_\_\_

Date

AUG 30 1939 19

S. J. LEWIS Scout