


Section 28 Township 8S Range 16W

Well No. #2 Gager

Company Crow Drlg.etal

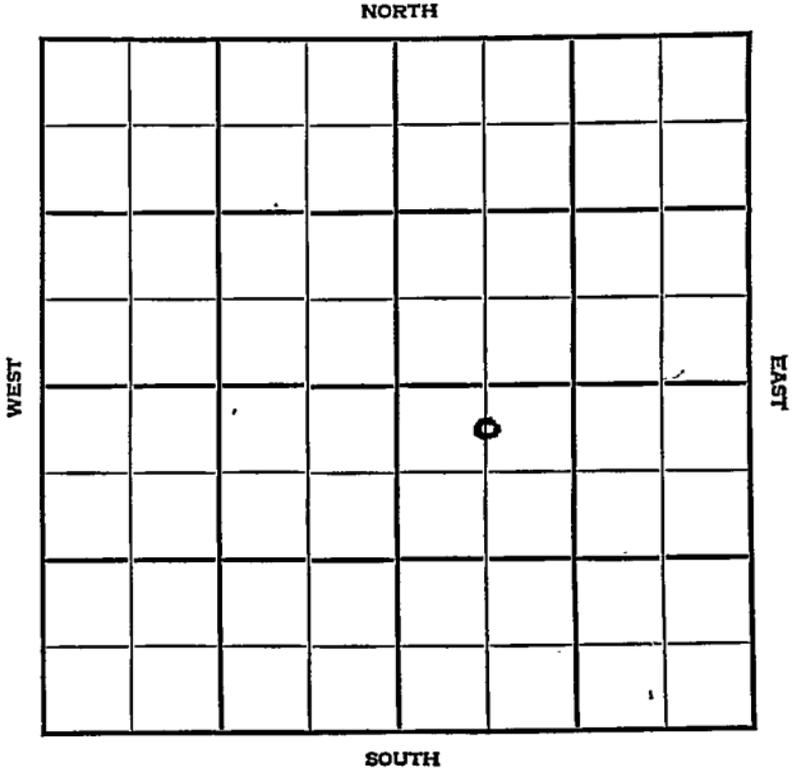



Sec. 28 Twp. _____ R. 16W

Well No. #2 Gager Farm _____

Crow Drlg. et al Company _____

Laton Pool


330' Ft. from N. Line

_____ Ft. from S. Line

_____ Ft. from E. Line

660' Ft. from W. Line

C N E NW SE

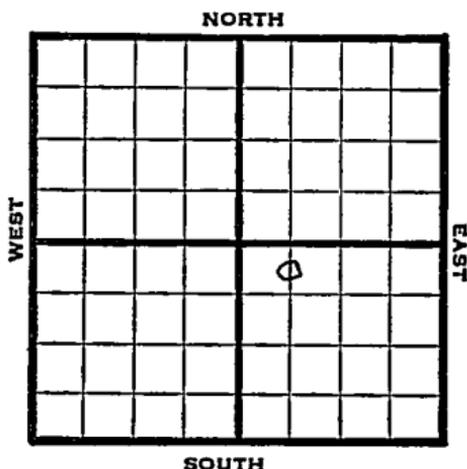

1948

Eli 1891' REPORT

- 6/9 8" @ 155'
Drlg. 980'
- 6/16 Drlg. 2981'
- 6/23 Lansing 3007'
TD 3244-
5" @ 3244'
RUST
- 6/29 "
- 6/8 TD 3228'
- 7/14 12 shots 3230-23
12 shots 3211-17
18 shots 3184-93'
23 shots 3081-92'
12 shots 3062-66'
12 shots 3038-43
4000 acid swb 12 bbls oil PH 3 hrs.
- 7/21 " "
- 7/28 Pump 54 bbls oil 24 hrs.
- 8/4 "
- 8/11 "
- 8/18 Lansing 3007'
5" @ 3244'
TD 3244'
Perf 4000 acid
Pump 75 oil Pot
27° Gr.

Comp
COMPLETED

Map No. _____ Sec. 28 Twp. 8 R. 16W

Well No. 2 Gager

Crow Drlg. etal.

Company

FIRST REPORT

Contractor

C N L NW SE

SECTION PLAT

330 Ft. from N. Line

_____ Ft. from S. Line

_____ Ft. from E. Line

660 Ft. from W. Line

		o	

Rooks County

Location _____

Rig up _____

Drilling and Remarks:

8" @ 155

drlg. 980

RECORD

Cased _____ in., _____ ft.

Sand _____

Gas _____

Oil _____

Total Depth _____

PRODUCTION

1st 24 hrs. Nat. _____

1st 24 hrs. after shot. _____

Gas _____ Cu. Ft.

Dry Hole _____

Abandoned _____

Date

JUN 9 1948

19

S. J. LEWIS

Scout

Rooks County Kansas State

Map No. 64 Sec. 28 Twp. 8 R. 16W

Well No. 2 Gager

Crow Drlg. etal. Company

COMPLETE

CNL NW SE

Contractor

E1.1891

SECTION PLAT

330 Ft. from N. Line

 Ft. from S. Line

 Ft. from E. Line

660 Ft. from W. Line

Laton Pool

Remarks:

Lane 3007
5" @ 3244
7703244
Prof.
4000 acid
Pump 75 oil Pot

279/80

Date

AUG 1 8 1948

Scout

S. J. LEWIS