


Section 28 Township 8 Range 16W

Well No. 3 Gager

Company Crowe Drlg

Laton
NORTH

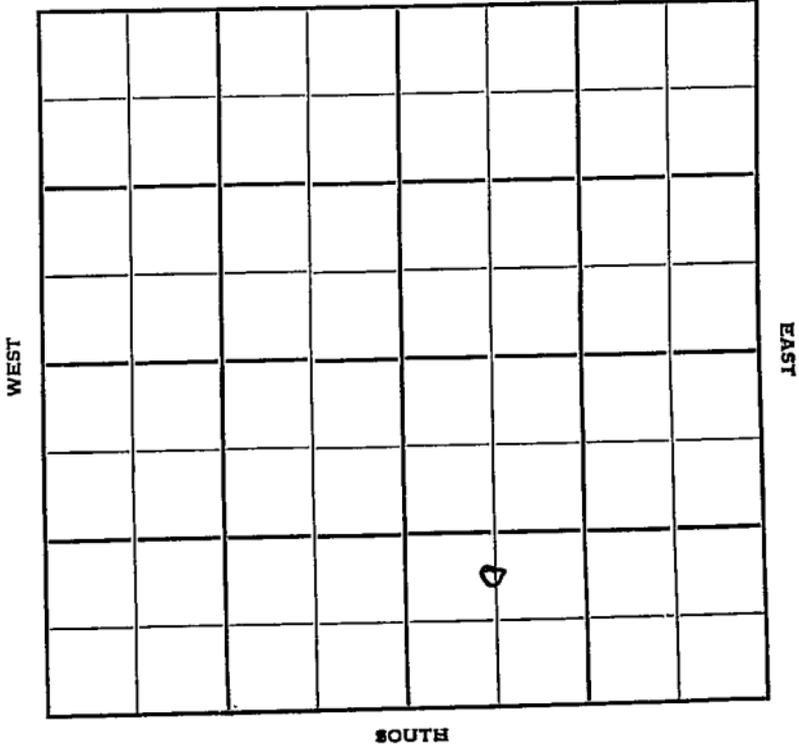

Sec. 28 Twp. 8 R. 16W ✓

Well No. #3 Gager Farm

Crowe Drlg. Company


Laton Pool

_____ Ft. from N. Line

990' Ft. from S. Line

_____ Ft. from E. Line

660' Ft. from W. Line

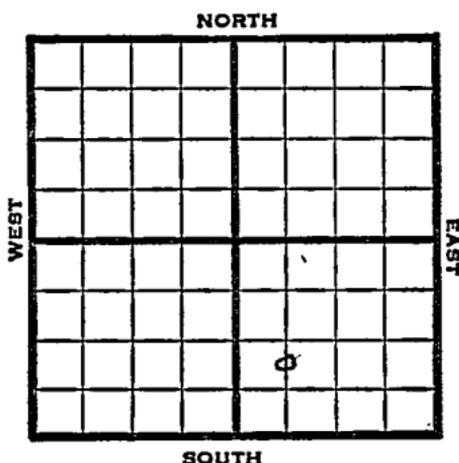

C N L SW SE

1949

Elev 1897' REPORT

4/20

Drlg. 1850'

4/27

Lansing 3007'

TD 3237

4" @ 3237'

5/4

"

5/11

TD 3237'

Lans 3007'

4" @ 3237'

Perf 2000 acid

Pump 30 oil Pot

27° Gr.

Comp

COMPLETED

Kansas

Map No. _____ Sec. 28 Twp. 8 R. 16W

Well No. 3 Gager

Crowe Drlg. _____ Company

FIRST REPORT Contractor

C N L SW SE

SECTION PLAT

_____ Ft. from N. Line

990 Ft. from S. Line

_____ Ft. from E. Line

660 Ft. from W. Line

		o	

Rooks County

Location _____

Rig up _____

Drilling and Remarks: _____

drlg. 1850

RECORD

Cased _____ in., _____ ft.

Sand _____

Gas _____

Oil _____

Total Depth _____

PRODUCTION

1st 24 hrs. Nat. _____

1st 24 hrs. after shot _____

Gas _____ Cu. Ft.

Dry Hole _____

Abandoned _____

Date

APR 20 1949

19

S. J. LEWIS

Scout

