


Section 28 Township 8 Range 16W

Well No. #1 Gager

Company Derby Oil

Laton Pool

NORTH

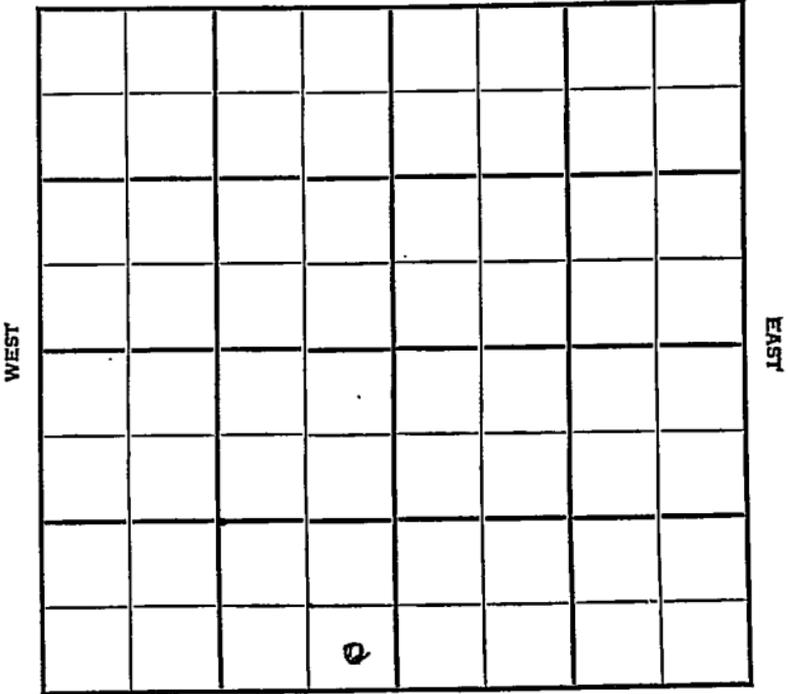

SOUTH



Sec. 28 Twp. 8 R. 16W

Well No. #1 Gager Farm

Derby Oil Company

Laton Pool


         Ft. from N. Line

330' Ft. from S. Line

330' Ft. from E. Line

         Ft. from W. Line

SE SW

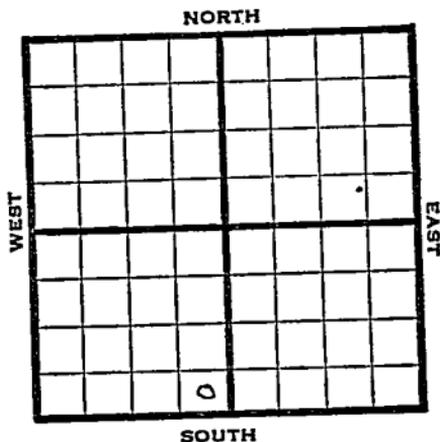

1948

Elev. 1958' REPORT

- 3/24 Location
- 3/31 "
- 4/7 "
- 4/14 "
- 4/21 8" @ 180'  
Drlg. 2025'
- 4/28 TD 3300'  
5" @ 3299'  
RUST
- 5/5 23 shots 3382-90' - 1000 acid.  
Swb. 15 gals. W PH  
Plug 3251'  
44 shots 3232-48' 1000 acid.  
1500' oil.
- 5/12 Lansing 3086'  
5" @ 3299'  
Perf.  
2500 acid  
Pump 140 oil / 12 W Pot  
27.0 Gr.  
TD 3300'  
Comp.

**COMPLETED**

Laton Pool

Map No. \_\_\_\_\_ Sec. 28 Twp. 8 R. 16W


Well No. 1 Gager  
Derby Oil Company

**FIRST REPORT** Contractor

SE SW

**SECTION PLAT**

\_\_\_\_\_ Ft. from N. Line  
330 Ft. from S. Line  
330 Ft. from E. Line  
\_\_\_\_\_ Ft. from W. Line

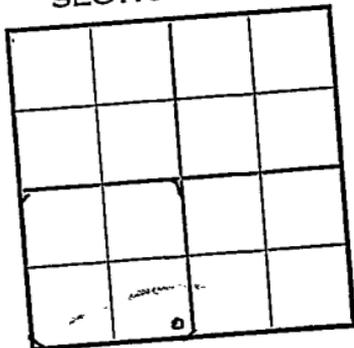

Rooks County

Location X

Rig up \_\_\_\_\_

Drilling and Remarks:

**RECORD**

Cased \_\_\_\_\_ in., \_\_\_\_\_ ft.

Sand \_\_\_\_\_

Gas \_\_\_\_\_

Oil \_\_\_\_\_

Total Depth \_\_\_\_\_

**PRODUCTION**

1st 24 hrs. Nat. \_\_\_\_\_

1st 24 hrs. after shot \_\_\_\_\_

Gas \_\_\_\_\_ Cu. Ft.

Dry Hole \_\_\_\_\_

Abandoned \_\_\_\_\_

Date

MAR 24 1948 19 \_\_\_\_\_

S. J. LEWIS Scout

Laton Pool

Form 26—200 Bks.—1-48—Palace  
Kansas

Map No. 64 Sec. 28 Twp. 8 R. 16W

Well No. 1 Gager

Derby Oil Company

**COMPLETE**

Contractor

SE SW

*E. 1958*  
SECTION PLAT


         Ft. from N. Line

330 Ft. from S. Line

330 Ft. from E. Line

         Ft. from W. Line

Rooks County

Location         

Rig up         

Drilling and Remarks:

*Lane 3086*

*5" 63287*

*Perf.*

*1500 acid*

*Prod 140 oil + 12W*

*PS*

*27° 62*

RECORD

Cased          in.,          ft.

Sand         

Gas         

Oil

Total Depth 3300

PRODUCTION

1st 24 hrs. Nat.         

1st 24 hrs. after shot         

Gas          Cu. Ft.

Dry Hole         

Abandoned         

Date

MAY 12 1948

19

S. J. LEWIS

Scout