


Section 28 Township 8 Range 16W

Well No. 1 Harrison

Company Derby Oil

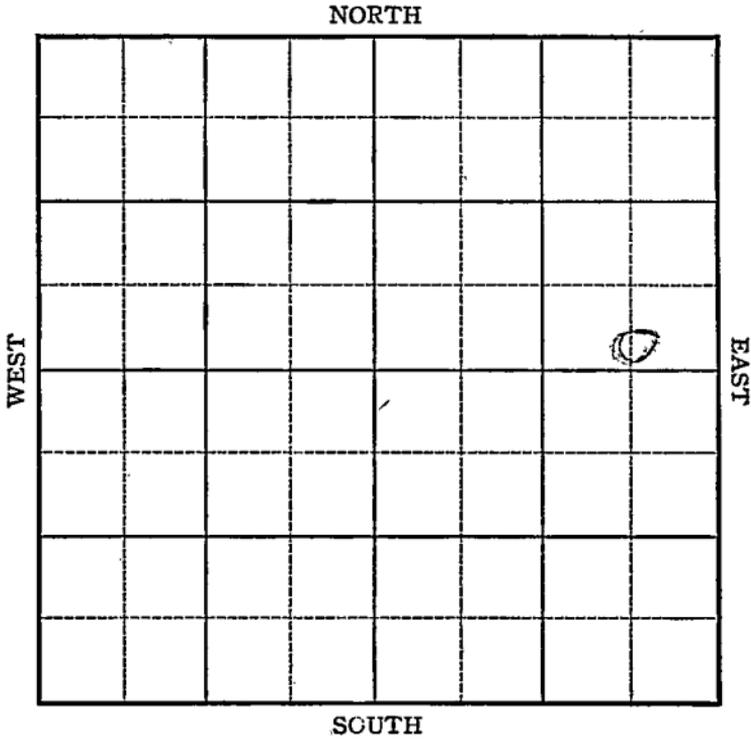

Sec. 28 Twp. 8 R. 16W

Well No. 1 Harrison Farm

Derby Oil Company


Wildcat

\_\_\_\_\_ Ft. from N. Line

330 Ft. from S. Line

660 Ft. from E. Line

\_\_\_\_\_ Ft. from W. Line

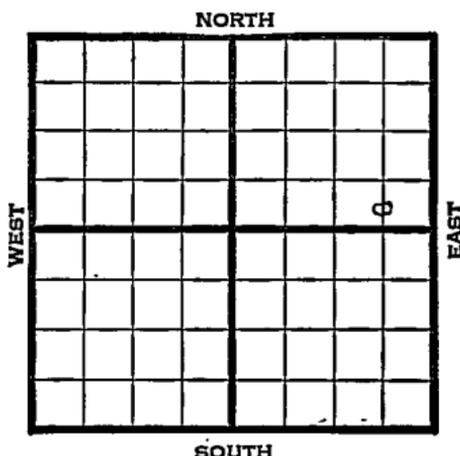

C S L SE NE

1945

Elev. 1939

REPORT

5/29

Location

6/8 10" @ 280 Drlg. 1723

6/27 Lans 3058

Arb 3428

5" @ 3227

PB perf. Lans 5500 acid.

1000 Butane

TD 3445

Pump 160 Pot.

Grav. 27.0

COMPLETED


Kansas Pool Name WildcatMap No. 64 Sec. 28 Twp. 8 R. 16WWell No. 1 HarrisonDerby Oil Company

FIRST REPORT

Contractor

C S L SE NE

SECTION PLAT

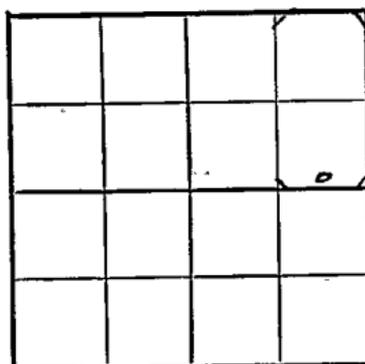         Ft. from N. Line330 Ft. from S. Line660 Ft. from E. Line         Ft. from W. Line

Rooks County

## RECORD

Location XCased          in.,          ft.Rig up         Sand         

Drilling and Remarks:

Gas         Oil         Total Depth         

## PRODUCTION

1st 24 hrs. Nat.         1st 24 hrs. after shot         Gas          Cu. Ft.Dry Hole         Abandoned         

Date

MAY 29 1945 19S. J. LEWIS Scout

Kansas Pool Name Wildcat

Map No. 64 Sec. 28 Twp. 8 R. 16W

Well No. 1 Harrison

Derby Oil Company

**COMPLETED** Contractor

C S L SE NE

E 1, 1939  
SECTION PLAT

         Ft. from N. Line

330 Ft. from S. Line

660 Ft. from E. Line

         Ft. from W. Line


Rooks County

Location         

Rig up         

Drilling and Remarks:

*Line 3058  
 QX 3428 5' 0327  
 P.B. Perf Lewis  
 5000 acid  
 1000 Bu. tar  
 Pump 160 P.D.  
 270 Gr*

**RECORD**

Cased          in.,          ft.

Sand         

Gas         

Oil         

Total Depth 3445

**PRODUCTION**

1st 24 hrs. Nat.         

1st 24 hrs. after shot         

Gas          Cu. Ft.

Dry Hole         

Abandoned         

Date

JUN 27 1945 19

S. J. LEWIS Scout