
Rooks KANSAS

DX 78-1

Section 28 Township 8 Range 17W

Well No. 1 Stamper "A"

Company Peel-Hardman

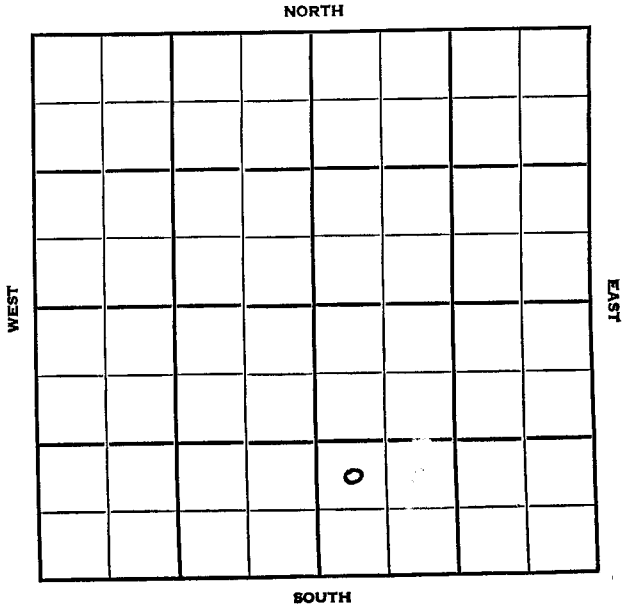

ROOKS KANSAS

SEC.	TWP.	R.
28	8	17W

WELL NO.
1 Stamper "A" FARM

COMPANY
Peel-Hardman

CONTRACTOR
Peel Bros-Contr.

Stamper Pool


_____ Ft. from N. Line

990 Ft. from S. Line

_____ Ft. from E. Line

330 Ft. from W. Line

NW SW SE

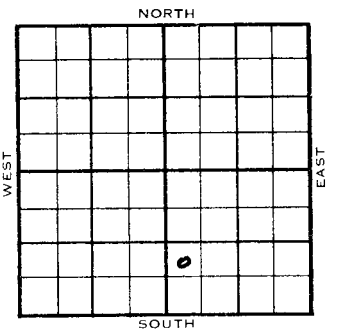

1954	ELEVATION 2008	REPORT
6/18		Location
6/30		8" @ 210'
		Drlg. 2110'
7/7		Heeb 3117', Lans 3158'
		DST 3254-63', 1/4 hrs., 30' M, 900#
		DST 3319-85, ½ hrs., 66' WCM, 960#
		Arb. 3441'
		DST 3442-47, ½ hrs., 30' OCM, 30' SOC 860#
		RTD 3447'
		5"@ 3443'
7/21		Spdg 6-25-54
		D&A
		TD 3449
		8" @ 210
		Heeb 3117 Lans. 3158
		DST 3254-63 open ¼ hr. Rec. 30' mud 900#
		DST 3319-85 open ½ hr. Rec. 66' wcm 960#
		Arb. 3441
		DST 3442-47 open ½ hr. Rec. 30' ocm 30' socm 860#
		TD 3449
		5" @ 3443
		CO to 3449 S/ 20 goph 2 hr. 500 A
		S/ 1 boph 8 hr. dec. to 0 2000 A

DX-78

OVER

Information brought forward

1954
7/21 SP 3425 14/3390-95 S/ 20 go 1 hr. 1000 A S/ 1 boph 14 hr. SP 3370 49/ 3338-54 24/ 3325-32 8 goph 12 hr. SP 3280 24/ 3259-67 1000 A S/ 2 boph 6 hr. CO to 3449
D&A

ABANDONED

FORM 275 FOR SALE BY KANSAS BLUE PRINT CO.


County Rooks State Kansas

Sec. 28 (Blk. Twp.) 8 (Sur. Rge.) 17W Map No.

Operator Peel-Hardman

Well No. 1 Farm Stamper "A"

Elev. Location NW SW SE

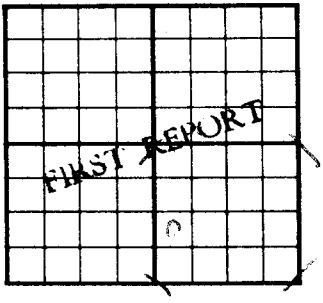

990 Ft. From S Line SE

330 Ft. From W Line Quarter

1st. Report JUN 23 195

Completion

Remarks

Peel Bros - Contr.

Spudding Date

Drlg. Data Stamper Pool

Location

J. G. McGEHEE

FORM 275 FOR SALE BY KANSAS BLUE PRINT CO.


County Rooks State Kansas

Sec. 28 (Blk. Twp.) 8 (Sur. Rge.) 17W Map No.

Operator Peel-Hardman

Well No. 1 Farm Stamper "A"

Elev. 2008 Location NW SW SE

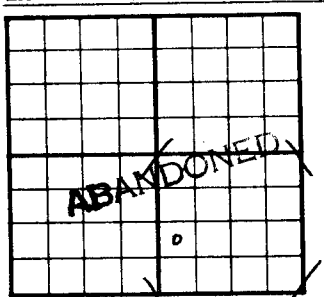

990 Ft. From S Line SE

330 Ft. From W Line Quarter

1st. Report

Completion JUL 21 [illegible]

Remarks Stamper Pool

Peel Bros - Contr.

Spudding Date 6-25-54

Drlg. Data D & A TD 3449

8" @ 210 Heeb. 3117 Lans. 3158

DST 3254-63 open ¼ hr. Rec. 30' mud

900# DST 3319-85 open ½ hr. Rec. 66'

wcm 960# Arb. 3441 DST 3442-47

open ½ hr. Rec. 30' ocm 30' socm 860#

TD 3449 5" @ 3443 CO to 3449

S/ 20 goph 2 hr. 500 A S/ 1 boph 8 hr.

dec. to 0 2000 A SP 3425 14/ 3390-95

S/ 20 go[illegible] 1 hr. 1000 A S/ 1 boph 14 hr

SP 3370 49/ 3338-54 24/ 3325-32

8 goph 12 hr. SP 3280 24/ 3259-67

1000 A S/ 2 boph 6 hr. CO to 3449

D & A

J. G. McGEHEE