


Section 28 Township 8 Range 17W

Well No. #1 Stamper "C"

Company Jones, Shelburne & Farmer

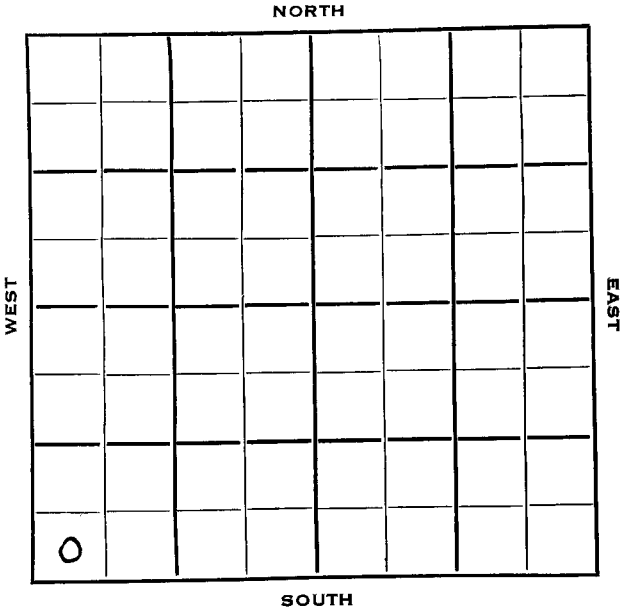

Sec. 28 Twp. 8 R. 17W

Well No. #1 Stamper "C" Farm

Jones, Shelburne & Farmer Company

Contractor

E. Dopita Pool


 Ft. from N. Line

330 Ft. from S. Line

 Ft. from E. Line

330 Ft. from W. Line

SW SW SW

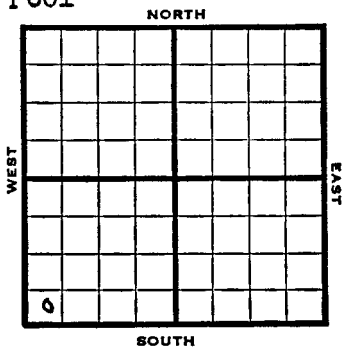

1953 Elev. 1990' REPORT

5/6 Spud 4-27-53
8" @ 145'
Anhy 1295' Heeb 3091, Tor 3111. KC 3129.
DST 3225-35 opn 1 hr, rec 120' gassy-oily-wtry mud. 40% oil, 920#
Drlg 3290'.

5/21 NR

5/28 "

6/3 "

6/17 Spud 4-27-53
Oil Well
TD 3426'
8" @ 145'
Anhy 1295, Heeb 3091, Tor 3111, KC 312
DST 3225-35 opn 1 hr, rec 120' gassy-oil-wtry mud 40% oil, 920# Arb 3417,
DST 3418-22 opn $\frac{1}{4}$ hr, rec 5' hocm, 960
DST 3421-26 opn 1 hr, rec 570' free oi 940#
TD 3426'
5" @ 3418'
CO to 3426
S/ 8 boph 5 hr.
Comp. 248 bopd.

COMPLETED

