


Section 28 Township 8 Range 17 W

Well No. # 7 Stamper "C"

Company Jones, Shelburne & Farmer

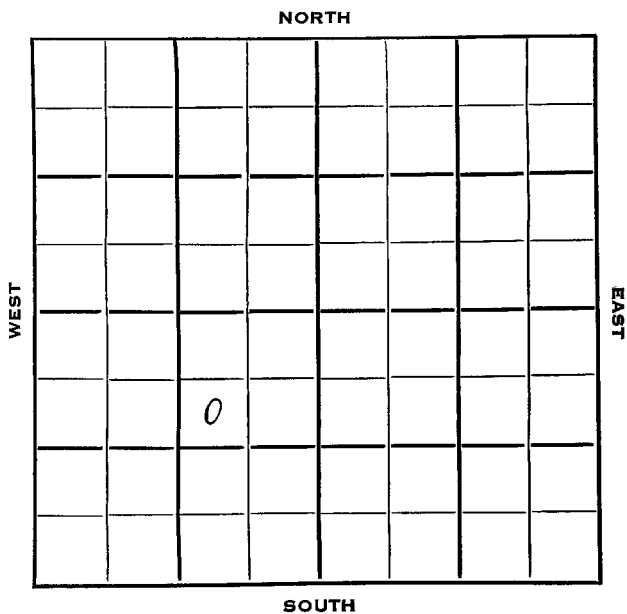

SEC.	TWP.	R.
28	8	17 W ✓

WELL NO.

7 Stamper "C"

FARM

COMPANY

Jones, Shelburne & Farmer

CONTRACTOR

J-S-F


990 _____ Ft. from N. Line

_____ Ft. from S. Line

990 _____ Ft. from E. Line

_____ Ft. from W. Line

SW NE SW

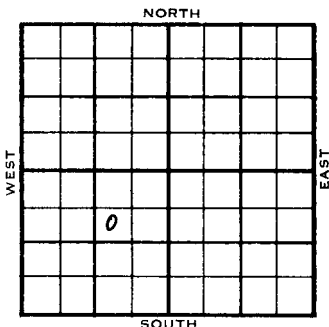

	ELEVATION	REPORT
1954	2002'	

3/24 Spud 3-21-54
8" @ 158 WOC

3/31 Anhy 1350 Heeb 3108 Lans 3148
DST 3205-22, 1 hr, 5' m 130#
DST 3240-67, 1/2 hr, 420' G & MCO
400' free oil 900#

4/21 Spud 3-21-54
Oil Well
TD 3432'
8" @ 158'
Anhy 1350', Heeb 3108', Lans 3148'
DST 3188-3205', opn 1 hr., rec. 5' mud, 130#
DST 3214-41', opn 1/2 hrs., rec. 1080' gas, 420' o & gcm, 300' free oil, 900 B KC 3335', Arb. 3428'
TD 3432'
5" @ 3429'
CO to 3432' 35 goph 500A
S/15 BOPH 3 hrs.
Comp. 120 BOPD

COMPLETED

