


## Rooks

DX 78-1

KANSAS

Section 28 Township 8 Range 17WWell No. 8 #2 Stamper "C"Company Jones, Shelburne & Farmer

NORTH

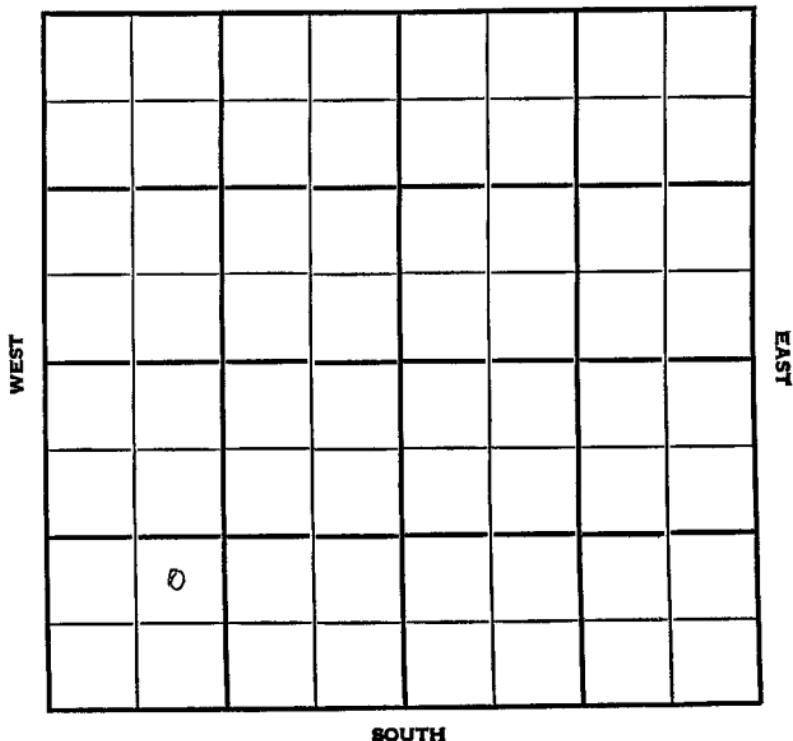

## Rooks KANSAS

SEC.	TWP.	R.
28	8	17 W

WELL NO.



#2 Stamper "C"

FARM

COMPANY

Jones, Shelburne &amp; Farmer

CONTRACTOR

## Stamper Pool


Ft. from N. Line

990 Ft. from S. Line

Ft. from E. Line

990 Ft. from W. Line

NE SW SW

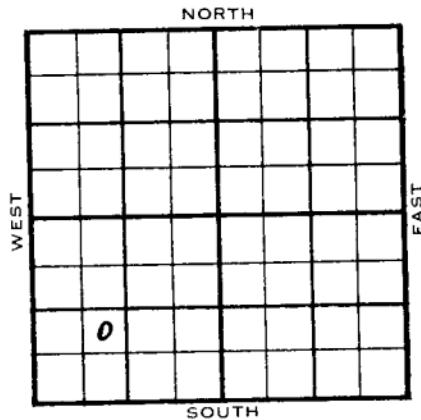

	ELEVATION 1993 <sup>1</sup>	REPORT
1954		
9/1	Location	
9/15	S pud 9-3-54 D & A TD 3476 8" @ 185 Anhy 1375 Heeb 3105 Tor. 3124 Lans 3144 B KC 3336 Cong. 3463 Arb. 3471 TD 3476 D & A	

ABANDONED

Kansat

Map No. 28 Sec. 28 Twp. 8 R. 17WWell No. 8 Stamper "C"


Jones, Shelburne &amp; Farmer Company

CORRECTION

Contractor

NE SW SW

## SECTION PLAT

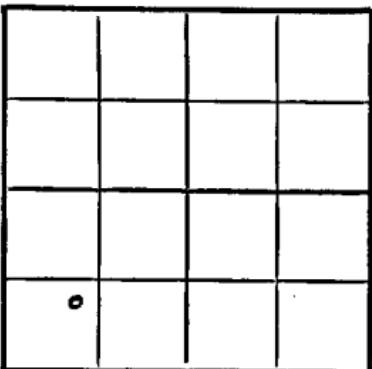

Ft. from N. Line

990 Ft. from S. Line

Ft. from E. Line

990 Ft. from W. Line

Rooks County

Location

Rig up

Drilling and Remarks:

Reported

#2 Stamper

## RECORD

Cased \_\_\_\_\_ in., \_\_\_\_\_ ft.

Sand \_\_\_\_\_

Gas \_\_\_\_\_

Oil \_\_\_\_\_

Total Depth \_\_\_\_\_

## PRODUCTION

1st 24 hrs. Nat. \_\_\_\_\_

1st 24 hrs. after shot \_\_\_\_\_

Gas \_\_\_\_\_ Cu. Ft.

Dry Hole \_\_\_\_\_

Abandoned \_\_\_\_\_

Date

SEP

8 19 19

FABEN GILSTRAP  
Scout

County Reeds State Kansas  
Sec. 28 (Blk.) 8 (Sur.) 17W Map No.    
(Twp.) (Rge.)

Operator Jones, Shelburne & Farmer

Well No. 2 Farm Stamper "C"

Elev. Location NE SW SW


990 Ft. From S Line SW

990 Ft. From  Line  Quarter

1st. Report SEP 1 1954

### Completion

### Remarks

Spudding Date

Drlg. Data **Stamper Pool**

## Stamper Pool

Location

## FÄDÉN GLSTER

County Rooks State KansasSec. 28 (Blk.) 8 (Sur. Rge.) 17W Map No. Operator Jones, Shelburne & FarmerWell No. 8 Farm Stamper "C"Elev. 1993 Location NE SW SW990 Ft. From S Line SW990 Ft. From W Line Quarter1st. Report Completion SEP 15 1954Remarks Stamper PoolSpudding Date 9-3-54Drilg. Data D & A TD 3476

8" @ 185 Anhy 1375 Heeb. 3105

Tor. 3124 Lans. 3144 B KC 3336

Cong. 3463 Arb. 3471 TD 3476

D &amp; A

FABEN GILSTRAP