

Sec. 28 Twp. 8 R. 19W

Well No. #8 Ververka Farm
Bird & Boreing Company

Ververka Pool


NORTH

990 Ft. from N. Line

Ft. from S. Line

330 Ft. from E. Line

Ft. from W. Line

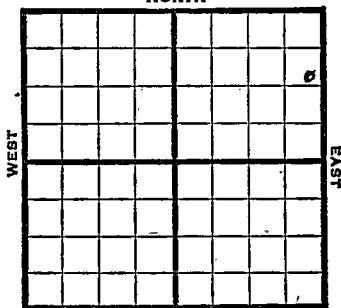

SE NE NE

SOUTH

1947

Elev. 2011'

REPORT

10/8

8" @ 260
anhy 1443
Drlg. 1863

10/15

Drlg. 3252'

10/22

Arbuckle 3448'
5" @ 3452'
TD 3458'
730' oil 6 hrs.

10/29

"

11/5

Pump 75 bbls oil & 20% W in 24 hrs.

11/12

"

"

11/19

"

"

11/25

"

"

12/3

Arbuckle 3448'
5" @ 3452'
Pump 83 oil & 50% Water Pot
Gr. 270
Total Depth 3458'

COMPLETED

Map No. _____ Sec. 28 Twp. 8 R. 19WWell No. 8 Ververka

Bird & Boreing _____ Company

FIRST REPORT

Contractor _____

SE NE NE


SECTION PLAT

990 Ft. from N. Line

_____ Ft. from S. Line

330 Ft. from E. Line

_____ Ft. from W. Line

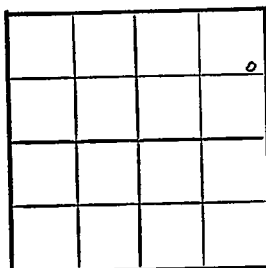

Rooks County

Location _____

Rig up _____

Drilling and Remarks:

8" @ 260

anhy 1443

drlg. 1863

RECORD

Cased _____ in., _____ ft.

Sand _____

Gas _____

Oil _____

Total Depth _____

PRODUCTION

1st 24 hrs. Nat. _____

1st 24 hrs. after shot _____

Gas _____ Cu. Ft.

Dry Hole _____

Abandoned _____

Date

OCT 8 1947

19

S. J. LEWIS

Scout

Ververka Pool

Form 26 200 Bks. 10-46 Petrol
Kansas

Map No. 65 Sec. 28 Twp. 8 R. 19W

Well No. 8 Ververka

Bird & Boreing Company

COMPLETE

Contractor

SE NE NE

E1,2011
SECTION PLAT

			0

990 Ft. from N. Line

 Ft. from S. Line

330 Ft. from E. Line

 Ft. from W. Line

Rooks County

Location

Rig up

Drilling and Remarks:

Per 8448

5" @ 3452.

Prod Boil + 50%
Water 80%

27° Gr

RECORD

Cased in., ft.

Sand

Gas

Oil

Total Depth 3452

PRODUCTION

1st 24 hrs. Nat.

1st 24 hrs. after shot

Gas Cu. Ft.

Dry Hole

Abandoned

Date

DEC 3 1947 19

S. J. LEWIS Scout