

KANSAS

Rooks


FORM 51 25M 3-49 PETROL

Section 28 Township 8 Range 19W

Well No. 1 Stice

Company Harry Gore

Hayden Pool
NORTH

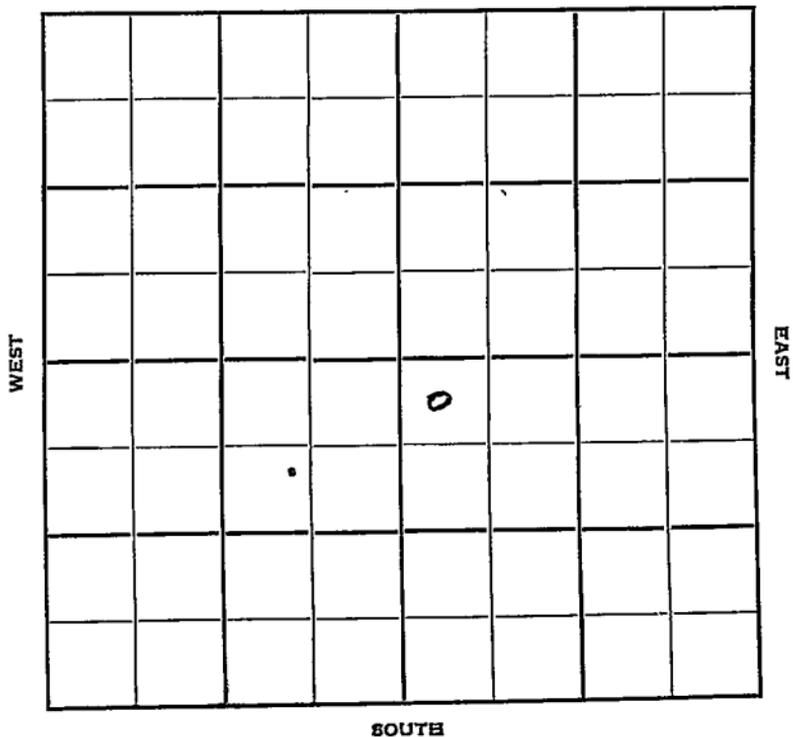

Sec. 28 Twp. 8 R. 19W

Well No. #1 Stice Farm

Harry Gore Company


Hyaden Pool

330' Ft. from N. Line

_____ Ft. from S. Line

_____ Ft. from E. Line

330' Ft. from W. Line

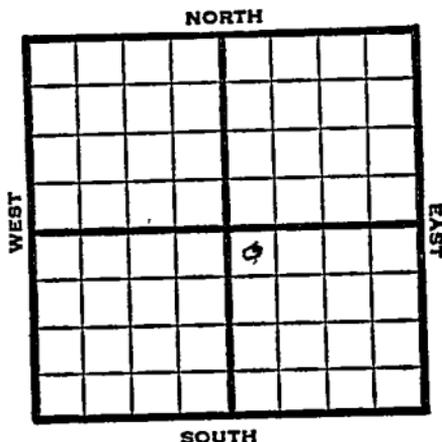

NW SE

1949 Elev 2039' REPORT

10/19	Location
10/26	"
11/1	8" @ 283'
11/9	Lansing 3231' Drlg. 3270'
11/16	"
11/23	TD 3477' 500 acid Swb 12 bbls fluid PH 18 hrs. 35% W
11/29	"
12/7	"
12/14	"
12/21	Pump 75 bbls oil / 100 W aday
12/28	"
1950	
2/15	TD 3477' 8" @ 283' 5" @ 3472' Lans 3231' Arb. 3470' P 75 BOPD / 100 wtr. Comp

COMPLETED

Hayden Pool

Map No. _____ Sec. 28 Twp. 8 R. 19W

Well No. 1 Stice _____ Company
Harry Gore _____ Contractor

FIRST REPORT
SECTION PLAT

NW SE

330 Ft. from N. Line

_____ Ft. from S. Line

_____ Ft. from E. Line

330 Ft. from W. Line

		o	

Rooks County

Location _____ x

Rig up _____

Drilling and Remarks:

RECORD

Cased _____ in., _____ ft.

Sand _____

Gas _____

Oil _____

Total Depth _____

PRODUCTION

1st 24 hrs. Nat. _____

1st 24 hrs. after shot _____

Gas _____ Cu. Ft.

Dry Hole _____

Abandoned _____

Date

OCT 19 1949 19

S. J. LEWIS Scout

Map No. _____ Sec. 28 Twp. 8 R. 19W

Well No. 1 Stice

Harry Gore Company

Company

Contractor

NW SE


E. 2039
SECTION PLAT

330 Ft. from N. Line

_____ Ft. from S. Line

_____ Ft. from E. Line

330 Ft. from W. Line

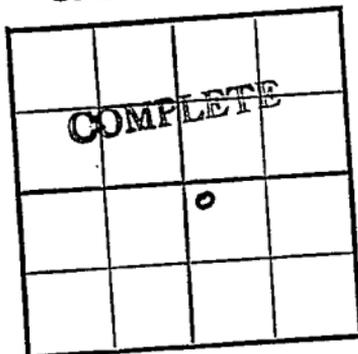

Rooks County

Location _____

Rig up _____

Drilling and Remarks:

8" @ 283'

5" @ 3472

Lans 3231

amb 3470

P 75 BOPD

+ 100 Water

RECORD

Cased _____ in., _____ ft.

Sand _____

Gas _____

Oil _____

Total Depth 3477

PRODUCTION

1st 24 hrs. Nat. _____

1st 24 hrs. after shot _____

Gas _____ Cu. Ft.

Dry Hole _____

Abandoned _____

Date

FEB 15 1950 19

J. E. TYRA Scout