


KANSAS
FORM 51 IOM 12-46 PETROL

Section 28 Township 8 Range 19-W

Well No. #7 Ververka

Company Bird & Boreing
Ververka

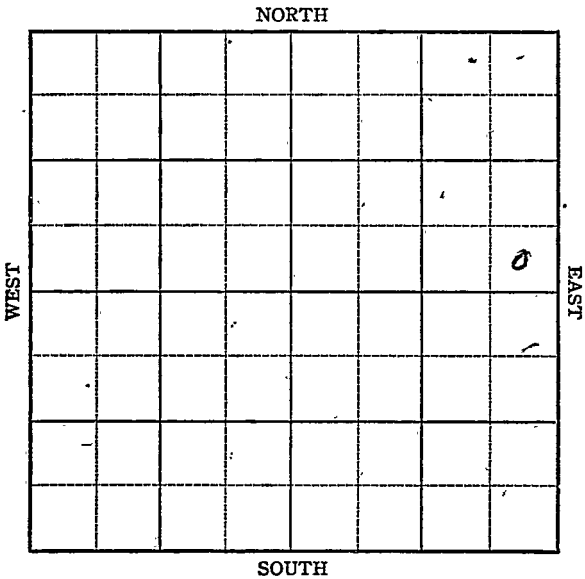

Well No. # 7 Ververka Farm

Bird & Boring Company


Ververka

 Ft. from N. Line

330 Ft. from S. Line

330 Ft. from E. Line

~~330~~ Ft. from W. Line

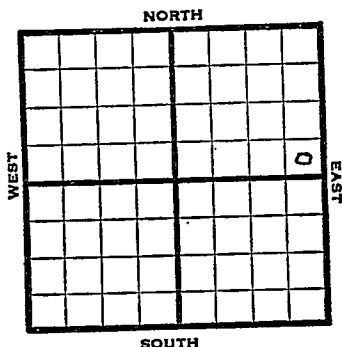

SE NE

REPORT

1947

Elev 2011'

6/18

Location

6/24

8" @ 250'
Drlg 2305'

7/1

Lansing 3159'
Arbuckle 3434'
TD 3452
5" @ 3449'
RUST

7/9

Drlg 3453'

7-16

"

7/22

T.D. 3453'

7/29

"

8/6

"

8/12

Arb 3434'
5" @ 3449'
Depth Pot. 1066'
oil / 52% W
Gr. 27
T.D. 3453'
Complete

COMPLETED

Map No. 65 Sec. 28 Twp. 8 R. 19W

Well No. 7 Ververka

Bird & Boreing Company

FIRST REPORT Contractor

SE NE

SECTION PLAT

 Ft. from N. Line

330 Ft. from S. Line

 Ft. from E. Line

330 Ft. from W. Line

		0	

Rooks County

RECORD

Location X

Rig up

Drilling and Remarks:

Cased in., ft.

Sand

Gas

Oil

Total Depth

PRODUCTION

1st 24 hrs. Nat.

1st 24 hrs. after shot

Gas Cu. Ft.

Dry Hole

Abandoned

Date

JUN 1 8 1947 19

S. J. LEWIS

Scout

