

KANSAS

Rooks

Section 28 Township 8 Range 19-W

Well No. #9 Ververka

Company Bird & Boering
Webster Pool

NORTH

						0	

WEST

EAST

SOUTH

KANSAS

Rooks

Sec. 28 Twp. 8 R. 19W

Well No. #9 Ververka Farm Bird & Boering

Company Webster Pool


200' Ft. from N. Line

Ft. from S. Line

990' Ft. from E. Line

Ft. from W. Line

NW NE SE

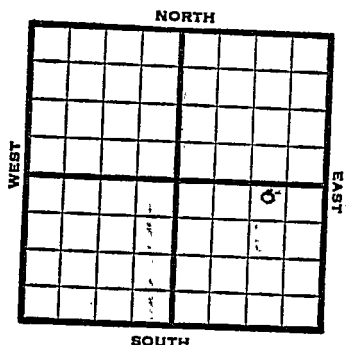

1948

Elev 2014' REPORT

12/8	8" @ 279'
12/15	Drlg 3025'
12/22	Arbuckle 3440-83'
	TD 3483'
	5"@ 3479'
12/29	"
1/5	Lansing 3174'
1/12	500 acid 1200' oil
1/19	PB 3475'
	12 shot s 3460-75
1/26	"
2/2	"
2/9	"
2/16	"
2/23	Pump 25 bbls oil 8 hrs. SW
3/2	"
3/8	"
3/15	TD 3483'
	Arb 3440'
	5"@ 3479'
	Perf 500 acid
	Pump 44 oil / 93 % W Pot
	23° Gr.
	Comp

COMPLETED

Kansas

Map No. _____ Sec. 28 Twp. 8 R. 19WWell No. 9 Ververka

Bird & Boering

Company

FIRST REPORT

Contractor

NW NE SE

SECTION PLAT

			6

200 Ft. from N. Line

_____ Ft. from S. Line

990 Ft. from E. Line

_____ Ft. from W. Line

Rooks County

RECORD

Location _____

Cased _____ in., _____ ft.

Rig up _____

Sand _____

Drilling and Remarks:

Gas _____

8" @ 279

Oil _____

Total Depth _____

PRODUCTION

1st 24 hrs. Nat. _____

1st 24 hrs. after shot _____

Gas _____ Cu. Ft.

Dry Hole _____

Abandoned _____

Date

DEC 8 1948 19S. J. LEWIS

Scout

Kansas

Webster Pool

Map No. K65 Sec. 28 Twp. 8 R. 19WWell No. 9 Ververka

Bird & Boreing

Company

COMPLETE

Contractor


E1,2014

NW NE SE

SECTION PLAT

200 Ft. from N. Line Ft. from S. Line990 Ft. from E. Line Ft. from W. Line

Rooks County

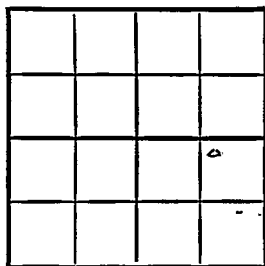

Location

Rig up

Drilling and Remarks:


RECORD

Cased in., ft.Sand Gas Oil Total Depth 3473

PRODUCTION

1st 24 hrs. Nat. 1st 24 hrs. after shot Gas Cu. Ft.Dry Hole Abandoned

Date

MAR 16 1949

19

S. J. LEWIS

Scout