

DX 78-1


Rooks

KANSAS

Section 28 Township 8 Range 19W

Well No. #10 Ververka

Company Bird & Peel Hardman

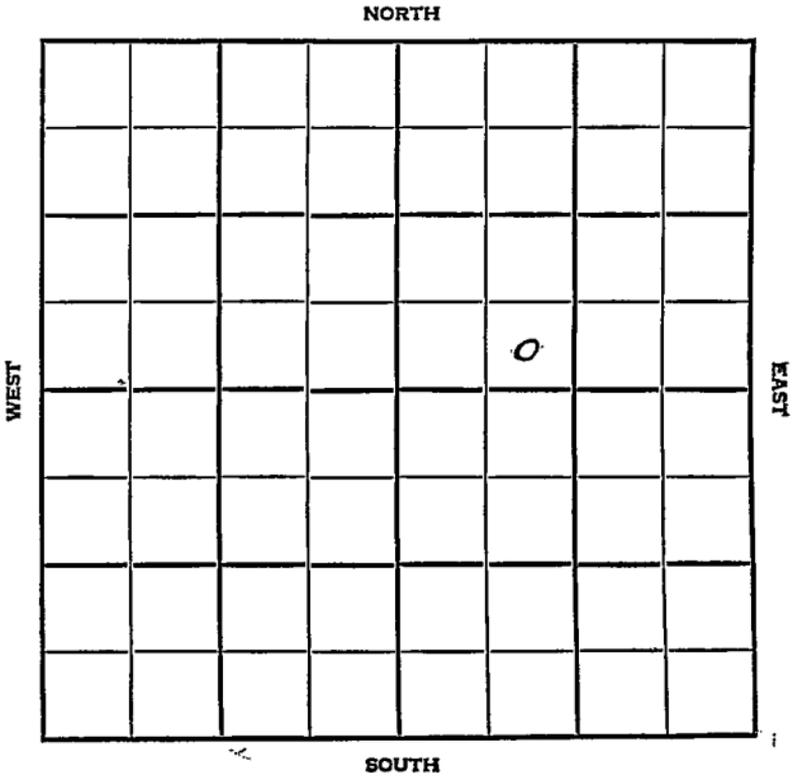

Rooks

KANSAS

| | | |
|------|------|------|
| SEC. | TWP. | R. |
| 28 | 8 | 19 W |

WELL NO.

10 Ververka

COMPANY

FARM

Bird & Peel-Hardman

CONTRACTOR

Peel

Webster Pool

Ft. from N. Line

330


Ft. from S. Line

Ft. from E. Line

990

Ft. from W. Line

SE SW NE

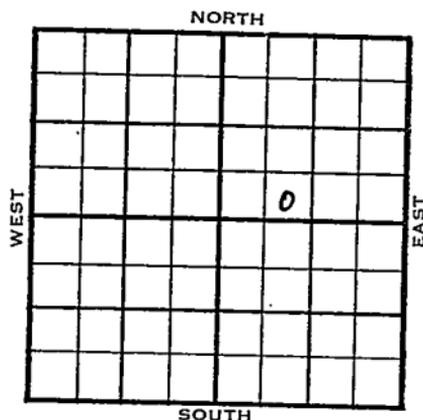

1954

ELEVATION

2033'

REPORT

10/27
12/8

Location
 Spud 10-27-54
 Oil Well
 TD 3478'
 8-5/8" @ 187'
 Anhy 1460', Heeb 3181' Lans 3222'
 DST 3251'-62' opn 1 hr, rec 1750' s.w.
 1140#
 DST 3335'-93' opn 1 hr, rec 285' s.w.
 1095# Arb. 3463'
 30/ 3468-73 S/ 3 bfph 98% Wtr.
 5" @ 3475'
 6/ 3473-74 18/ 3465-68 S/ 13 bfph
 98% Wtr. 500 A S/ 13 bfph . 60% Wtr.
 Comp 10 bopd. 98% Wtr.

COMPLETED

