


Section 28 Township 8 Range 19 W

Well No. # 2 Ververka "A"

Company K & E Drlg.

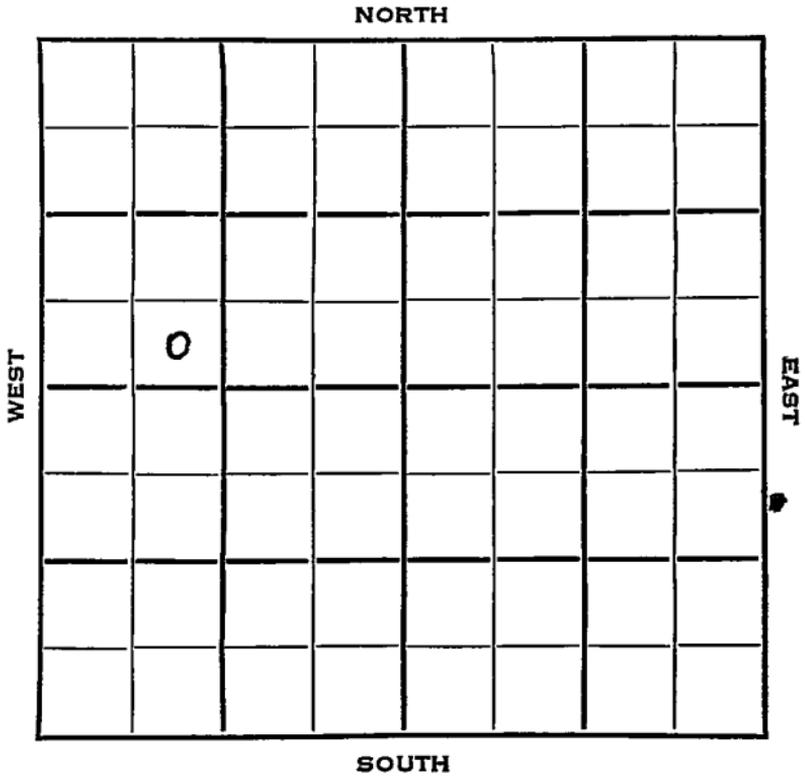

Rooks

KANSAS

SEC.	TWP.	R.
28	8	19 W ✓

WELL NO.

# 2 Ververka "A"

FARM

COMPANY

K &amp; E Drlg.

CONTRACTOR

K &amp; E Drlg.

Webster Pool

\_\_\_\_\_ Ft. from N. Line

330


\_\_\_\_\_ Ft. from S. Line

\_\_\_\_\_ Ft. from E. Line

990

\_\_\_\_\_ Ft. from W. Line

SE SW NW

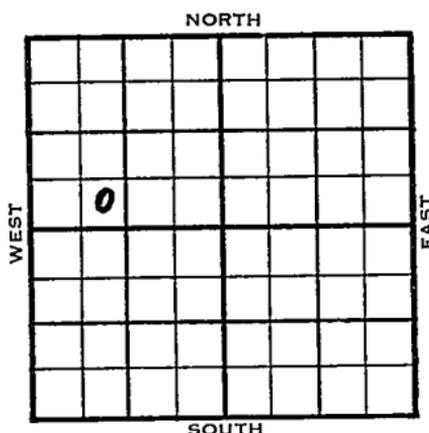

1953

ELEVATION

2057'

REPORT

9/30

8" @ 187

Drlg. 2682'

10/7

D &amp; A

10/14

D&amp;A

TD 3540'

8" @ 187'

DST 3268-86, opn 1 hr., rec. 300' sw,  
1098 WDST 3507-11, opn 1 hr., rec. 10' sw,  
690#DST 3509-35, opn 1 hr., rec. 990' sw,  
1020#

Heeb 3204, Lans 3244, Arb 3507

TD 3540

D&amp;A

**ABANDONED**



