


KANSAS

Rooks county
Ververka pool

Section 28 Township 8 Range 19W

Well No. #1 #5 Ververka - "B"

Company Bird & Boreing

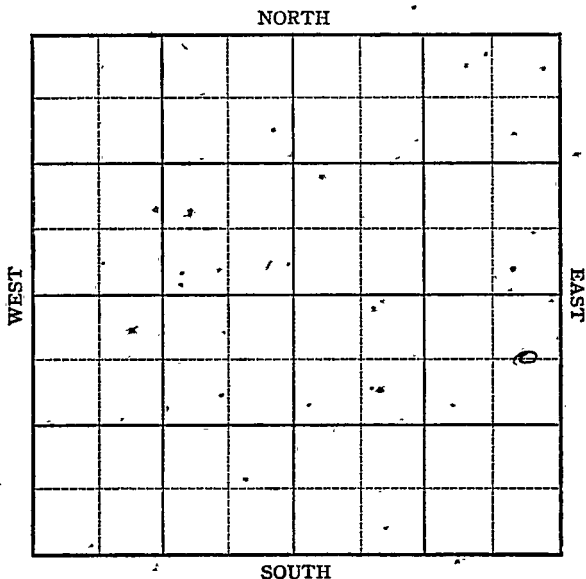

KANSAS

Books

R. 19-W

Sec. 28 Twp. 8

Well No. ~~#1~~ ^{#5} Ververka "B" Farm

Bird & Boring

Company


Ververka Pool

660 Ft. from N. Line

Ft. from S. Line

330 Ft. from E. Line

Ft. from W. Line

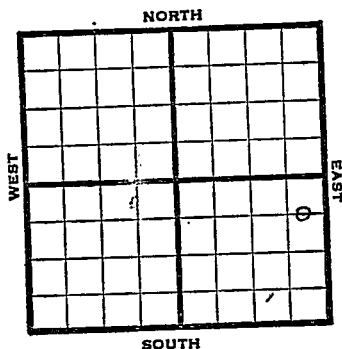

C E L N E S E

Elev. 2003' REPORT

1947

4/16 Location

4/23 8" @ 235'
Drlg 3120'

4/29 Arbuckle 3428'
TD 3430'
5" @ 3428'
RUST

5/7 " "

5/13 " "

5/20 " "

5/28- Arb 3428
5" @ 3428'
Depth Pot 3058
Wax 3000
Grav. 25
TD 3430'

COMPLETED

Ververka Pool

Form 26 200 Bks. 10-46 Petrol
Kansas

Map No. K65 Sec. 28 Twp. 8 R. 19W

Well No. 5 Ververka

Bird & Boreing

Company

FIRST REPORT

Contractor

C E L N E S E

SECTION PLAT

660 Ft. from N. Line

 Ft. from S. Line

330 Ft. from E. Line

 Ft. from W. Line

			o

Rooks County

Location X

Rig up

Drilling and Remarks:

RECORD

Cased in, ft.

Sand

Gas

Oil

Total Depth

PRODUCTION

1st 24 hrs. Nat.

1st 24 hrs. after shot

Gas Cu. Ft.

Dry Hole

Abandoned

Date

APR 16 1947 19

S. J. LEWIS Sco

Form 26 200 Bks. 10-46 Petrol

KANSAS

Ververka Pool

Map No. 1565 Kansas

Sec. 28

Twp. 8

R. 19W

Well No. 1 Ververka "B"

Bird & Boreing

Company

CORRECTION

Contractor

C E L NE SE


660 Ft. from N. Line

Ft. from S. Line

330 Ft. from E. Line

Ft. from W. Line

SECTION PLAT

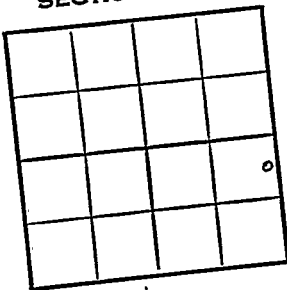

Rooks County

Location

Rig up

Drilling and Remarks:

Reported as
#5 Ververka

RECORD

Cased _____ in., _____ ft.

Sand

Gas

Oil

Total Depth

PRODUCTION

1st 24 hrs. Nat.

1st 24 hrs. after shot

Gas _____ Cu. Ft.

Dry Hole

Abandoned

Date

APR 30 1947

19

S. J. LEWIS

Scout

Kansas

KANSAS Ververka Pool

Map No. 65 Sec. 28 Twp. 8 R. 19WWell No. 5 Ververka "B"

Bird & Boreing

Company

COMPLETE

C E L N E S E

Contractor

E. I. 2003

SECTION FLAT

660 Ft. from N. Line

Ft. from S. Line

330 Ft. from E. Line

Ft. from W. Line

Rooks County

Location

Rig up

Drilling and Remarks:

Cen 8 3428.

5' @ 3428.

Depth 3428

Max 3000

25-Gr

RECORD

Cased _____ in., _____ ft.

Sand _____

Gas _____

Oil _____

Total Depth 3430

PRODUCTION

1st 24 hrs. Nat. _____

1st 24 hrs. after shot _____

Gas _____ Cu. Ft.

Dry Hole _____

Abandoned _____

Date

MAY 28 1947

19

S. J. LEWIS

Scout