

O.W.W.O.

Section 28 Township 8 Range 22W

MOORE

Well No. #1 Hutton

Imperial

Company ~~Lee Phillips & Strain Drlg.~~

NORTH

SW SW SW

WEST

EAST

0							

SOUTH

Sec. 28 Twp. _____ R. _____

Well No. #1 Hutton Farm _____

Lee Phillips & Strain Drlg. Company Company

Strain Drlg. - Contr. Contractor

Wildcat


_____ Ft. from N. Line

330' Ft. from S. Line

_____ Ft. from E. Line

330' Ft. from W. Line

SW SW SW

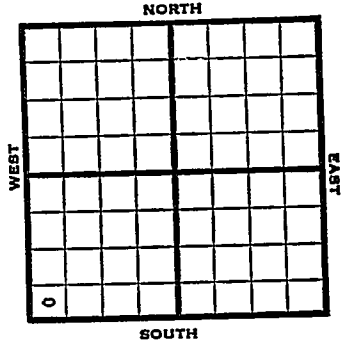

1951

Elev. 2192'

REPORT

4/11

Location

4/25

D & A TD 3900'

Top. 3200' Heeb 3413' Tor. 3437'

KC 3452' B KC 3671' Cong 3813'

Arb. 3863' TD 3900' D & A

ABANDONED

O.W.W.O.

WILDCAT

S-513-B

County Graham Elev. 8200

Sec. 28 Twp. 8 Rge. 22W

Company Imperial

Farm Name Moore No. 1

	TOPS	DEPTH	LOG	DATUM
Anh.				
Tp.				
H.				
Tr.				
Dg.				
B.L.				
L.				
K.C.				
B.K.C.				
Ce.				
C.				
M.				
M.				
K.				
Mz.				
Mq.				
V.				
S.				
S.				
A.				
R.				
Pf.				
G.				
T.D.				

Loc. in Sec. X
SW SW SW

Geol.

Contr.

Co. Tools #1

Pool

Wildcat

APR 16 1958
FIRST REPORT

Date Comm. 4/14/58

Co.


Lse.

No.

Sec.

T.

R.

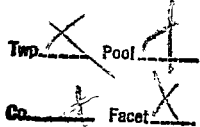

O.W.W.O.

P.B.A.)

5-513-B

County Graham Elev 21950 F
 Sec. 28 Twp. 8 Rge. 22W
 Company Imperial
 Farm Name Moore No. 1

TOPS	DEPTH	LOG	DATUM
Anh.			
Tp.			
H.			
Tr.			
Dg.			
B.L.			
L.			
K.C.			
B.K.C.			
Ce.			
C.			
M.			
M.			
K.			
Mz.			
Mq.			
V.			
S.			
S.			
A.			
R.			
Pf.			
G.			
T.D.			

Loc. in Sec. SW SW SW
 Geol. O.W.W.O.
 Contr. Co. Tools #1
 Pool Wildcat

ABANDONED
 MAY 14 58
 0

Date Comm. 4/14/58 (O.W.W.O.)

APR 23 58 old info: Lee Ph. 1115 1st Hutton
Lsg 3452 Atb 3863 OTD 3900
new: CO 3710 4 1/2" 3710/125
w OCT APR 20 58 MAY 7 58 16/3640-44
16/3621-25 110A 290ph 6 hrs
1 1/2 30wph 9 hrs \$ 2 1/2 30wph
40 hrs 12/3659-62 \$ 4,130 + 3 1/2
13wph 14 hrs SQ MAY 14 58 16/3607-09
110A \$ 190ph + w 3 hrs (K) \$ 53wph 12 hrs
1000' 013 PB 3519 16/3488-92

6 4 1/2 Bw ph + scum oil 14 hrs

D&A