

**O.W.W.O.**

Section 28 Township 8 Range 22W

Well No. #1 ~~Hutton~~ MOORE

Company ~~Lee Phillips & Strain Drlg.~~ Imperial

NORTH *sw sw sw*

0							

WEST

EAST

SOUTH

Sec. 28 Twp. 8 R. 22W ✓

Well No. #1 Hutton Farm

Lee Phillips & Strain Drlg. Company

Strain Drlg. - Contr. Contractor

Wildcat


         Ft. from N. Line

330' Ft. from S. Line

         Ft. from E. Line

330' Ft. from W. Line

SW SW SW

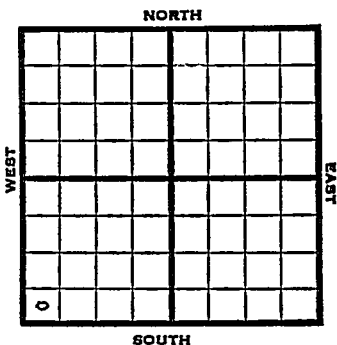

1951

Elev. 2192' REPORT

4/11

Location

4/25

D & A TD 3900'

Top. 3200' Heeb 3413' Tor. 3437'

KC 3452' B KC 3671' Cong 3813'

Arb. 3863' TD 3900' D & A

**ABANDONED**





O.W.W.O.

# WILDCAT

~~Imperial Pool~~  
~~Imperial Pool~~

S-513-B

County Graham Elev. 2501  
 Sec. 28 Twp. 8 Rge. 22W  
 Company Imperial  
 Farm Name Moore No. 1

TOPS	DEPTH	LOG	DATUM
Anh.			
Tp.			
H.			
Tr.			
Dg.			
B.L.			
L.			
K.C.			
B.K.C.			
Ce.			
C.			
M.			
M.			
K.			
Mz.			
Mq.			
V.			
S.			
S.			
A.			
R.			
Pf.			
G.			
T.D.			

Loc. in Sec. X  
SW SW SW  
 Geol. \_\_\_\_\_  
 Contr. \_\_\_\_\_  
 Co. Tools #1

Pool  
Wildcat

APR 16 1958  
**FIRST REPORT**

Date Comm. 4/14/58

Co.


Use

No.

Sec.

T.

R.

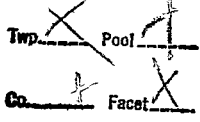

O.W.W.O.

83.1

S-513-B

County Graham Elev 21950 F  
 Sec. 28 Twp. 8 Rge. 22W  
 Company Imperial  
 Farm Name Moore No. 1

TOPS	DEPTH	LOG	DATUM
Anh.			
Tp.			
H.			
Tr.			
Dg.			
B.L.			
L.			
K.C.			
B.K.C			
Ce.			
C.			
M.			
M.			
K.			
Mz.			
Mq.			
V.			
S.			
S.			
A.			
R.			
Pf.			
G.			
T.D.			

Loc. in Sec. SW SW SW  
 Geol. O.W.W.O.  
 Contr. Co. Tools #1  
 Pool Wildcat

**ABANDONED**  
 MAY 14 '58

Date Comm. 4/14/58 (O.W.W.O.)  
 APR 23 '58 old info: Lee Phillips Hutter  
Lsg 3452 Atb 3863 OTP 3900  
new: Co 3710 4 1/2" 3710/125  
w oct APR 20 '58 MAY 7 '58 16/3640-44  
16/3621-25 110A \$ 290ph 6 hrs  
1 1/2 Bwph 9 hrs \$ 2 1/2 Bwph  
40 hrs 12/3659-62 \$ 4 B0 + 3 1/2  
13 wph 14 hrs 59 MAY 14 '58 16/3607-09  
110A \$ 190ph + w 3 hrs (K) \$ 5 Bwph 12 hrs  
1000' 83 PB 3519 16/3488-92

Co.  
Lsg  
No.  
Sec.  
T  
R

6 4 1/2 Bw ph + scum oil 14hrs

D&A