

KANSAS

Sheridan County

FORM 51 IOM 12-46 PETROL


Section 28 Township 8 Range 26-W

Well No. 1 Hansen "E"

Company Cities Service

Wildcat

NORTH

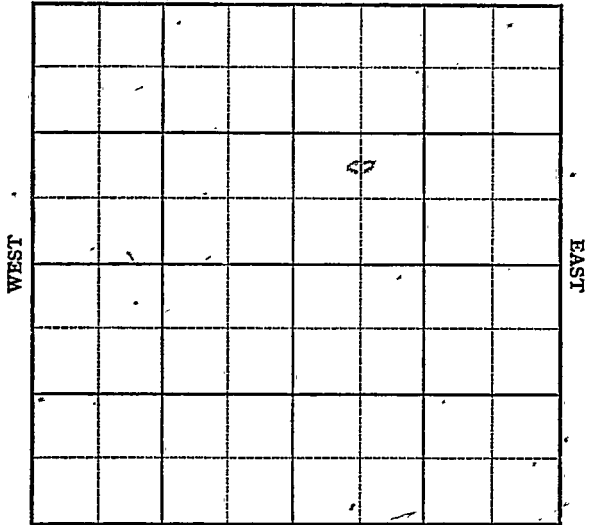

SOUTH

7

KANSAS Sheridan County ✓

Sec. 28 Twp. 8 R. 26W

Well No. 1 Hansen "B" Farm

Cities Service Company

Wildcat


Ft. from N. Line

990 Ft. from S. Line

Ft. from E. Line

660 Ft. from W. Line

C N L SW NE

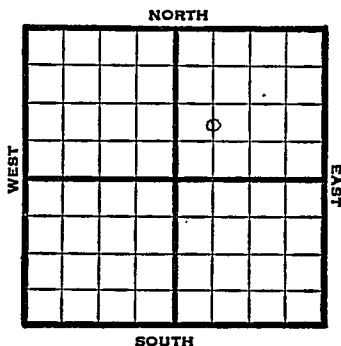

1947	Elev. 2533' REPORT
7-16	Loc. 8" @ 250 Drlg. 2815
7/22	Lansing 3698' BK.C. 3934' T.D. 3950' Run csg.
7/30	5" @ 3922' RUST
8/6	"
8/13	1000 acid & pumped 24 bbls. oil & 58 water in 15 hrs.
8/20	70 shots 3740-52 2000 acid Pump 30 bbls oil & 3 W in 8 hrs.
8/27	"
9/3	Lans. 3698' 5" @ 3934' Perf. Lans. 3500' acid Pump 11 oil / 45 W Pot 27.0 Gr. TD 3950'

COMPLETED

Map No. _____ Sec. 28 Twp. 8 R. 26^{1st}

Well No. 1 Hansen "E"

Cities Service


Company

FIRST REPORT

Contractor

NE SW NE

SECTION PLAT

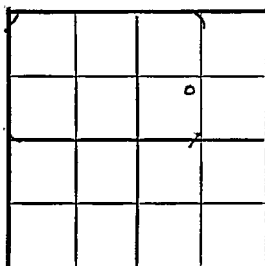

_____ Ft. from N. Line

990 _____ Ft. from S. Line

_____ Ft. from E. Line

990 _____ Ft. from W. Line

Sheridan County

Location X

Rig up

Drilling and Remarks:

RECORD

Cased _____ in., _____ ft.

Sand _____

Gas _____

Oil _____

Total Depth _____

PRODUCTION

1st 24 hrs. Nat. _____

1st 24 hrs. after shot _____

Gas _____ Cu. Ft.

Dry Hole _____

Abandoned _____

Date

JUL 9 1947 19

S. J. LEWIS

Scout

Map No. _____ Sec. 28 Twp. 8 R. 26W

Well No. 1 Hansen "E" ✓

Cities Service

Company

CORRECTION + 1st report

Contractor

C N L SW NE

SECTION PLAT

_____ Ft. from N. Line

990 Ft. from S. Line

_____ Ft. from E. Line

660 Ft. from W. Line

Sheridan County

Location _____

Rig up _____

Drilling and Remarks:

Reported

NE SW NE

RECORD

Cased _____ in., _____ ft.

Sand _____

Gas _____

Oil _____

Total Depth _____

PRODUCTION

1st 24 hrs. Nat. _____

1st 24 hrs. after shot _____

Gas _____ Cu. Ft.

Dry Hole _____

Abandoned _____

Date

JUL 16 1947 19

S. J. LEWIS Scout

Map No. 67 Sec. 28 Twp. 8 R. 26W

Well No. 1 Hansen "E"

Cities Service Company

COMPLETE

Contractor

C N L SW NE

F12523
SECTION PLAT

		6	

990 Ft. from N. Line

660 Ft. from S. Line

660 Ft. from E. Line

660 Ft. from W. Line

Sheridan County

RECORD

Location _____

Cased _____ in. _____ ft.

Rig up _____

Sand _____

Drilling and Remarks:

Gas _____

Lane 3688

Oil _____

5-23 3937

Total Depth *3952*

Perf Lane

3600 acid

Pump 17 oil + 45W

RD

27-8-47

PRODUCTION

1st 24 hrs. Nat. _____

1st 24 hrs. after shot _____

Gas _____ Cu. Ft.

Dry Hole _____

Abandoned _____

Date

SEP 3 1947

S. J. LEWIS

Scout