


Section 29 Township 8 Range 17W

Well No. 1 Stamper

Company Peel-Hardman

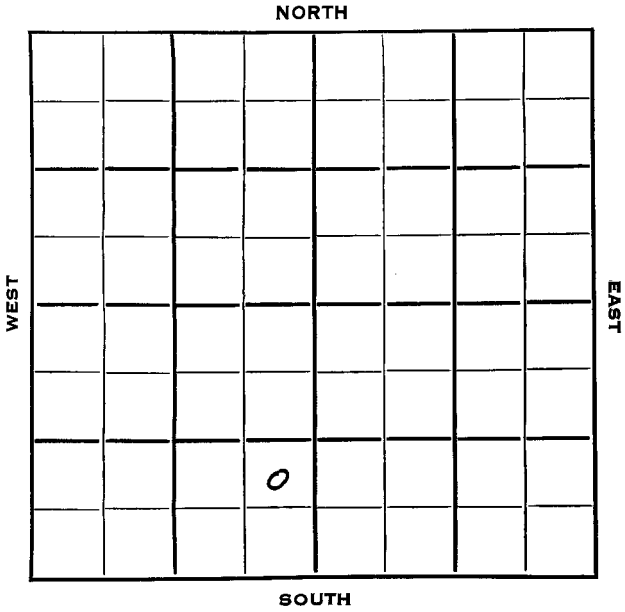

Rooks

KANSAS

SEC.	TWP.	R.
29	8	17W ✓

WELL NO. #1 Stamper FARM

COMPANY Peel- Hardman

CONTRACTOR Peel


Dopita Pool

\_\_\_\_\_ Ft. from N. Line

990 \_\_\_\_\_ Ft. from S. Line

330 \_\_\_\_\_ Ft. from E. Line

\_\_\_\_\_ Ft. from W. Line

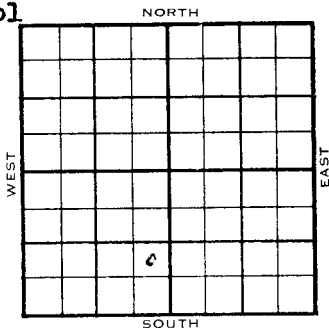

NE SE SW

	ELEVATION	REPORT
1954	1950'	

4/21 Spud 4-16-54  
8" @ 189'  
Drlg 2200'

5/12 Spud 4-16-54 D & A TD 3415  
8" @ 189 Heeb 3063  
DST 3036-55 open 3/4 hr, rec 45'  
wtr. 1070# KC 3101  
DST 3205-20 open 1 hr rec 40' wtr.  
880#  
DST 3289-3345 open 1/2 hr rec 10' mud  
620# Arb. 3388  
DST 3381-91 open 1/2 hr rec 4' mud 500#  
TD 3405 5" @ 3401 CO to 3405  
500A 2000 A S/3 GOPH DD 3415  
SP 3394 12/3391-94 500 A  
S/36 GFPH SP 3360 12/3328-32  
2000 A S/2 1/2 BFPH 10% oil SP 3260  
12/3205-09 1000 A D & A

**ABANDONED**



