

DX 78-1


Rooks

KANSAS

Section 29 Township 8s Range 17W

Well No. #1 Stamper

Company El Dorado Ref Co

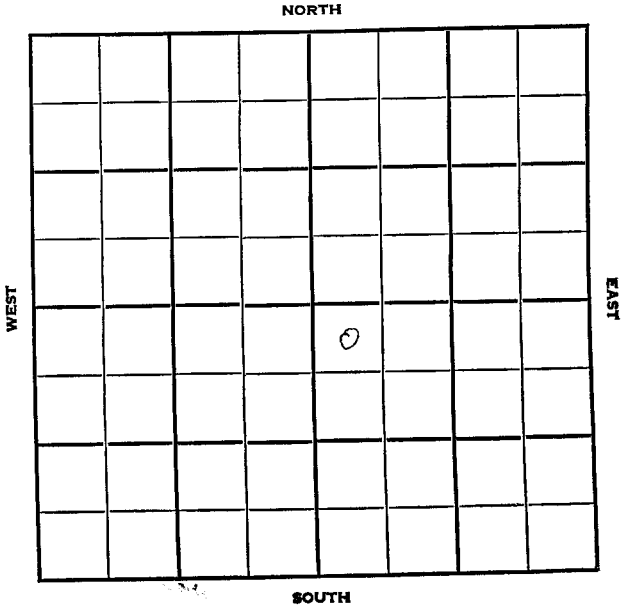

Rooks

KANSAS

SEC.	TWP.	R.
29	8	17W

WELL NO.

#1 Stamper

FARM

COMPANY

El Dorado Ref. Co.

CONTRACTOR

Mast Drlg.

Dopita East


_____ FT. FROM N. LINE

_____ FT. FROM S. LINE

_____ FT. FROM E. LINE

_____ FT. FROM W. LINE

NW NW SE

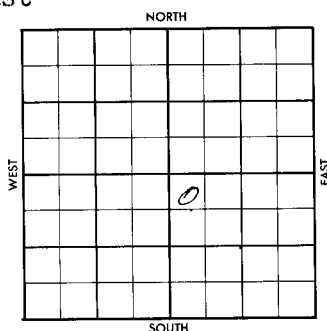

1956	ELEVATION	REPORT
	1976 DF	

8-8 Est. TD 3450'

8-22 Comm. 8-8-56
 8 5/8" @ 206 w/110
 DST 3040-52 op 1 hr., rec. 280' fluid
 (scum oil) BHP 1005/20";
 RTD 3446'
 D & A
 Anh. 1270'; H. 3095'; Tr. 3115';
 L. 3134'; G. 3116'; A. 3427';
 TD 3446'

ABANDONED

County Rock Elev. 17W
 Sec. 29 88 Res. Endorado Ref. Co.
 Company Stamper No. 1
 Farm Name _____

TOSS	DEPTH	LOG	DATUM	Loc. in Sec.
Anb.				NW NW SE
Tr.				
H.				
Tr.				
Dg.				
Bl.				
L.				Geol.
K.C.				Contr.
B.K.C.				East Drig.
Ce.				Pool
C.				Dopita East
M.				
M.				
K.				
Mz.				
Me.				
V.				
S.				
S.				
A.				
R.				
Pe.				
G.				

FIRST REPORT

TD **Est. TD 3450**

AUG 8 '56

Date Comm.

2001 3-1 2004

County Rocks Elev. 1976 DF
 Sec. 29 Twp. 8S Rge. 17W
 Company El Dorado Ref. Co.
 Farm Name Stamper No. 1

TOPS	DEPTH	LOG	DATUM	Loc. in Sec.
Ans.	1270			NW NW SE
TP.				
H.	3095			
Tr.	3115			
Dg.				
Bl.				
L.	3134			Geol.
H.C.				Cont.
BNC.				
Co.				Mast Drlg.
C.	3416			
M.				Pool
M.				Dopita East
K.				
Me.				
Mo.				
V.				
S.				
S.				
A.	3427			
R.				
PC.				
S.				
TD.	3446			

Date Comm.

Est. TD 3450

AUG 22 1956

AUG 15 '56

8-8-56 8⁵/₈ 206

1111 Any 1270 11 3032

AUG 22 '56 X DST (in Topeka no Top)

3040-52 op 1 hr sec. 280' Fluid
(sour oil) BHP 100.5/20" Hb 3095

Tr 3115 Lsg 3134 c9 3416 R16

3427 RTD 3446 Log?

D&A