

202 m
(WH8-F016) ✓


Graham

KANSAS

SECTION 29 TOWNSHIP 8 S RANGE 23 W

WELL NO. # 1 Art Kobler

COMPANY Woodman & Iannitti

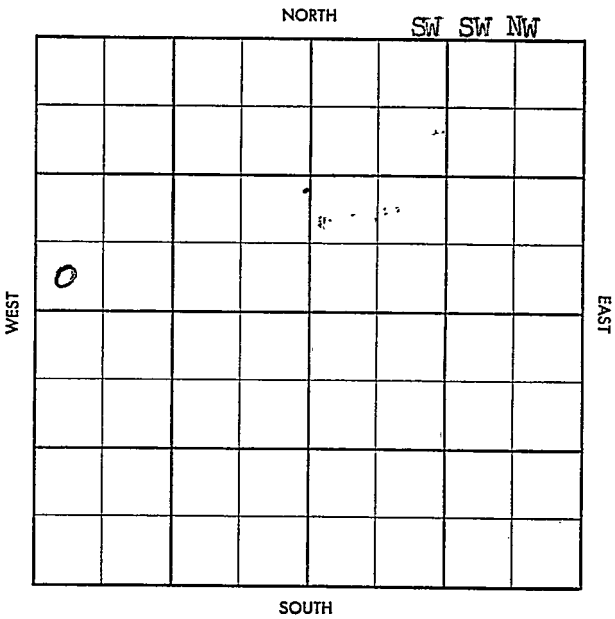

1958
6/3

Spud 5-18-58

8" @ 143 w/100

Tops: Anh. 2012', H. 3636',

Lans 3680', KC 3899'

DST 3790-3905', open 1 hr, rec. 35'

mud. BHP 820# 30". No log.

TD 3905' D & A 5-28-58 ✓

(Scout Completion Ticket)

ABANDONED

SEC. 29 TWP. 8 S R. 23 W

WELL NO. # 1 Kobler FARM


COMPANY (EXPLORATORY-UBOU) Woodman-Iannitti Drlg. Co.

CONTRACTOR Co. tools

Wildcat

NORTH 0277

FT. FROM N. LINE
FT. FROM S. LINE
FT. FROM E. LINE
FT. FROM W. LINE

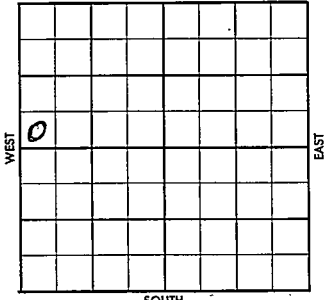

SW SW NW

SDX-FO (S-25982); Assign. & BHM of \$10,000.00

Table with columns for date, elevation, and report details. Includes entries for 1958, 5/9, 5/20, 5/21, 5/22, 5/23, 5/26, 5/27, 5/28, 5/29, and 6/2.

OVER

Twp. X Pool X
Co. X Facet X

810-N

S-513-B

County: Graham Elev. 2316 OF 2319
 Sec. 29 Twp. 8 Rge. 23W
Woodman & Hannitti
 Operator: Art Kobler No. 1

LOGS	DEPTH	LOG	DATUM
Surf	<u>2012</u>		
1p			
H.	<u>3686</u>		
Tr.			
Dg.			
B.L.			
L.	<u>3680</u>		
K.C.			
B.K.C.	<u>3899</u>		
Cb.	<u>DST</u>		
C.			
M.			
M.			
K.			
Mz.			
Mq.			
V.			
S.			
S.			
A.			
R.			
Pf.			
G.			
T.D.	<u>3905</u>		

Loc. In Sec. SW SW NW
 Geol. W#8-FAIL
 Contr. W#8-FAIL
 Co. Tools #1
 Pool Wildcat

ABANDONED
 JUN 3 '58

Date Comm. 5/18/58 (SMC - FO)
 Sit @ 143 w/100, Drle. 1450. MAY 28 '58 x Tops
3770 JUN 3 '58 → Tops DST 3790-
3905 1hr rec 35' M BHP
820/30" no log

D6A

JUN 5 1958

M. M.