


Section 29 Township 8 Range 21WWell No. #1 B.A. FoxCompany Texas

Graham KANSAS

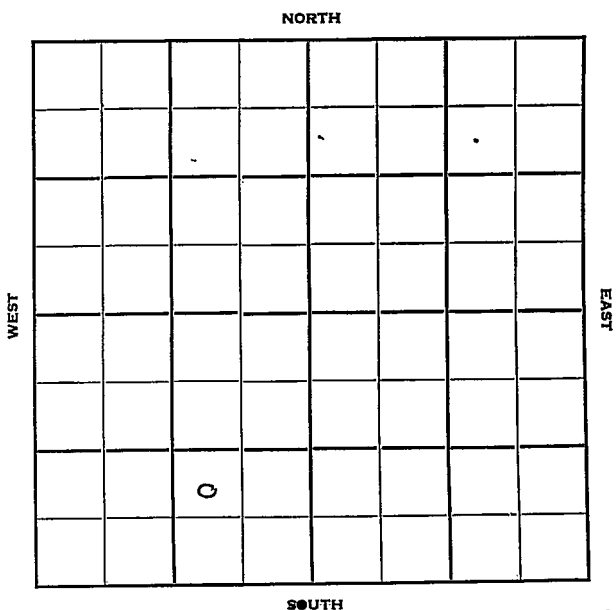

Sec. 29 Twp. 8 R. 24 W

Well No. # 1 B. A. Fox Farm

Texas Company

Noble Contractor

Wildcat


 Ft. from N. Line

990 Ft. from S. Line

990 Ft. from E. Line

 Ft. from W. Line

NW SE SW

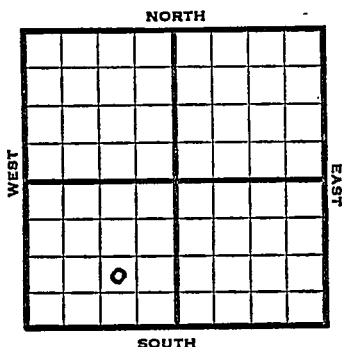

1952 Elev. 2336 REPORT

8/6 Spud 8-4-52

10" @ 317 WOC

8/13 Topeka 3425 Heeb. 3651

Tor. 3678 Lans. 3695

SO 3849-54 DST

8/20 DST 3838-54', 2 hrs, 35' OCM Off

DST 3839-60, 1 hr, 3' oil 37' OCM

250# 15"

B KC 3919' Marm 4029' Cong. 4176'

Miss li 4218' Simp 4338' Arb 4352'

DST 4351-60, 1 hr, 65' M

RTD 4400'

8/27 7" @ 3951 CO 3911 13/3882-92

10 galw 1 galoph 500 A

5 1/2 BOPH 2000 A S/5 1/2 BOPH

PB 3874 19/3850-56 2 boph & trace

wtr to A

9/3 CO 3911 1/2 BO & 1/4 Bwph PB 3825

16/ 3780-85 22 Bwph PB 3775

13/3768-72 10 galwph & SSO 500 A

S/ 3 1/2 Bwph & SSO PB 3756 18/ 3723-29

S/15 galwph PB 3717 22/ 3704-11 dry

500 A S/ 40 Bwph PB 3686 13/3678-82

dry 500 A 36 Bwph PB 3645

10/3490-93 9 Bwph


OVER

1952

9/10 Spud 8-4-52 D&A TD 4400
10" @ 317 Top 3425 Heeb. 3651
Tor. 3678 Lans. 3695 SO 3849-54
DST 3838-54 opn 2 hr. Rec. 35' ocm
O# DST 3839-60 opn 1 hr. Rec. 3'
oil 37' ocm 250# BKG 3919
Marm 4029 Cong 4176 Miss 4218
Simp 4338 Arb. 4352
DST 4351-60 opn 1 hr. Rec. 65' mud O#
TD 4400
Schlumberger Tops:
Top 3434 Heeb. 3651 Tor. 3675
Lans. 3691 BKG 3915 Cong 4195
Miss 4233 Simp 4330 Arb. 4351
7" @ 3951 CO to 3911
13/3882-92 10 gw 1 goph 500 A
S/ $\frac{1}{2}$ boph 2000 A S/ $\frac{1}{5}$ boph
PB 3874 19/3850-56 2 boph CO to 3911
 $\frac{1}{2}$ bo $\frac{1}{4}$ bwph PB 3825 16/3780-85
22 bwph PB 3775 13/3768-72
10 gwph & SSO 500 A S/ $\frac{1}{3}$ bwph
PB 3756 18/3723-29 S/15 gwph
PB 3717 22/3704-11 dry 500 A
S/40 bwph PB 3698 16/3692-96
30 bwph PB 3686 13/3678-82 dry
500 A 36 bwph PB 3645 10/3490-93
9 bwph TD 4400 D&A

ABANDONED

County Graham State Kansas
 Sec. 29 (Blk. 8) (Sur. 24W) Map No. 8
 Operator Texas
 Well No. 1 Farm B. A. Fox
 Elev. _____ Location NW SE SW

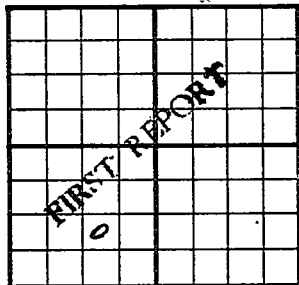


990 Ft. From S Line SW
990 Ft. From E Line Quarter
 1st. Report AUG 6 1952
 Completion _____
 Remarks _____
Noble - Contr.
 Spudding Date 8-4-52

Drilg. Data Wildcat
10" @ 317 WOC

J. G. McGEHEE

County Graham State Kansas
 Sec. 29 (Blk.) 8 (Sur.) 24W Map No.
 Operator Texas Company
 Well No. 1 Farm B. A. Fox
 Elev. 2336 Location NW SE SW

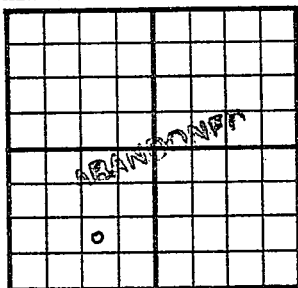

990 Ft. From S Line SW
990 Ft. From E Line Quarter
 Ist. Report
 Completion SEP 10 1952
 Remarks Wildcat
Noble Drlg. - Contr.
 Spudding Date 8-4-52

Drlg. Data D & A TD 4400

10" @ 317 Top. 3425 Heeb. 3651
Tor. 3678 Lans. 3695 SO 3849-54
DST 3838-54 open 2 hr. Rec. 35' ocm
0# DST 3839-60 open 1 hr. Rec. 3' oil
37' ocm 250# B KC 3919 Marm. 4029
Cong. 4176 Miss. 4218 Simp. 4338
Arb. 4352 DST 4351-60 open 1 hr.
Rec. 65' mud 0# TD 4400

SCHLUMBERGER TOPS

Top. 3434 Heeb. 3651 Tor. 3675
Lans. 3691 B KC 3915 Cong. 4195
Miss. 4233 Simp. 4330 Arb. 4351
7" @ 3951 CO to 3911 13/ 3882-92
10 gw 1 goph 500 A S/ 1/2 boph

J. G. McGEHEE
J. G. McGEHEE

Drig. Data

2000 A S/ $5\frac{1}{2}$ boph PB 3874. 19/ 3850-56

2 boph CO to 3911 $\frac{1}{2}$ bo $\frac{1}{4}$ bwph

PB 3825 16/ 3780-85 22 bwph PB 3775

13/ 3768-72 10 gwph & SSO 500 A

S/ $3\frac{1}{2}$ bwph PB 3756 18/ 3723-29

S/ 15 gwph PB 3717 22/ 3704-11 dry


500 A S/ 40 bwph PB 3698 16/ 3692-96

30 bwph PB 3686 13/ 3678-82 dry

500 A 36 bwph PB 3645 10/ 3490-93

9 bwph TD 4400

D & A

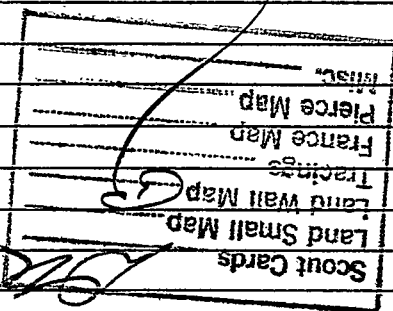

SEP 17 1968