


Graham

KANSAS

SECTION 29 TOWNSHIP 8 RANGE 24W

WELL NO. #4 Graham

COMPANY Imperial Oil Co.

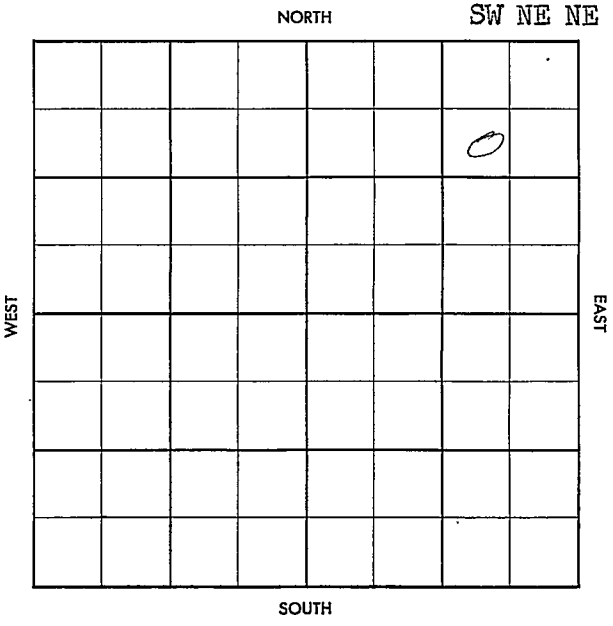

Co.

County Graham Elev. 2333

Sec. 29 Twp. 8 Rge. 24W

Company Imperial Oil Co.

Farm Name Graham No. 4

TOPS	DEPTH	LOG	DATUM	Loc. in Sec.
Anh.	2046			SW NE NE
TP.				
H.	3642			
Tr.	3663			
Dg.				
BL.				
L.	3680			Geol.
K.C.				Contr.
B.K.C.				Harris-jurt
Ce.				
C.				
M.				Pool
M.				Holley No.
K.				
Mz.				
Mo.				
V.				
S.				JUL 27 1957
S.				
A.				
R.				
PE.				
G.				ABANDONED
T.D.	3900			

L.S.

No.

Sec.

T.

R.

Date Comm. 6-1-57

SH - 220'17", Dr. - 650 JUN 12 57 3828

JUL 57 DST 3825-44' open

1hr rec 10' Md BHP 0" DST

3843-65 1hr rec 20' Md

+550 BHP 750 DST 3864

-85 1hr rec 30' Md BHP

820 5 1/2 3838/125-32/3859

-63 no show 1 1/2 Bwph

+550 8hr rec DEW to be used

JUL 3 1957 JUL 0 57 PB 3775 23/3761

-65 $\frac{11}{12}$ 6 Bwph PF
 120/3490-3510 $\frac{11}{12}$ input 157 ~~25~~

Bwph complete for SWP
 well, JUL 12 57 Complete for SWP
 well ~~157~~

29-8-24W

sw ne ne