

Section 29 Township 8 Range 24WWell No. #1 R. KeithCompany NCRA & Empire Drlg.

NORTH

WEST	0								EAST
SOUTH									

4

Graham KANSAS

SEC.	TWP.	R.
29	8	24W

WELL NO.

1 R. Keith

FARM

COMPANY

NCRA & Empire Drlg.

CONTRACTOR

Empire Drlg.


Wildcat

330 Ft. from N. Line

Ft. from S. Line

Ft. from E. Line

330 Ft. from W. Line

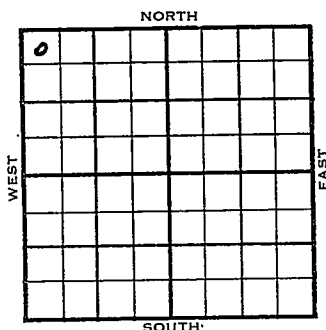

NW NW NW

	ELEVATION	REPORT
1954	2391'	
11/23	Spud 11-19-54 8" @ 182' Anhy 2113' Drlg. 2260'	
12/8	Spud 11-19-54 D & A TD 4505' 8" @ 182' Anhy 2113', Heeb 3694', Lans 3733' DST 3880'-3920' opn $\frac{1}{2}$ hr, rec 15' Mud 1000# Log Tops: Heeb 3694', Lans 3733' B KC 3956' Marm 4065' Cong 4226' Miss Chert. 4256' Miss Lime 4278', Kh. 4345' Viola 4354' Simp 4449', Arb. 4487' TD 4505' D & A	
		ABANDONED

County Graham State Kansas
 Sec. 29 (Blk.) 8 (Sur.) 24W Map No.
 Operator NCRA & Empire Drlg.
 Well No. 1 Farm R. Keith
 Elev. Location NW NW NW

0							

FIRST REPORT

330 Ft. From N Line NW
 330 Ft. From W Line Quarter

1st. Report. NOV 23 1954

Completion

Remarks

Empire Drlg. - Contr.

Spudding Date 11-19-54


Drlg. Data

Wildcat

8" @ 182 Anhy 2113 drlg. 2260

FABEN GILSTRAP

County Graham State Kansas
 Sec. 29 (Blk.) 8 (Sur.) 24W Map No.
 Operator NCRA & Empire Drlg.
 Well No. 1 Farm R. Keith
 Elev. 2391 Location NW NW NW

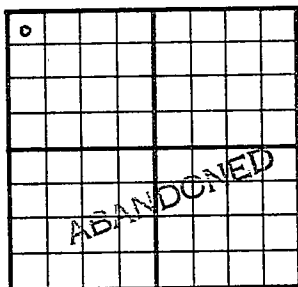

330 Ft. From N Line NW
330 Ft. From W Line Quarter

1st. Report

Completion DEC 8 1954

Remarks Wildcat

Empire Drlg. - Contr.

Spudding Date 11-19-54

Drlg. Data D & A TD 4505

8" @ 182 Anhy 2113 Heeb. 3694

Lans. 3733 DST 3880-3920 open $\frac{1}{2}$ hr.

Rec. 15' mud 1000# LOG TOPS:

Heeb. 3694 Lans. 3733 B KC 3956

Marm. 4065 Cong. 4226 Miss. chert 4256

Miss. lime 4278 Kh. 4345 Viola 4354

Simp. 4449 Arb. 4487 TD 4505

D & A

FABEN GILSTRAP