

Graham


KANSAS

FORM 51

Section 29 Township 8 Range 21W

Well No. #1 Emery

Company Peel-Hardman

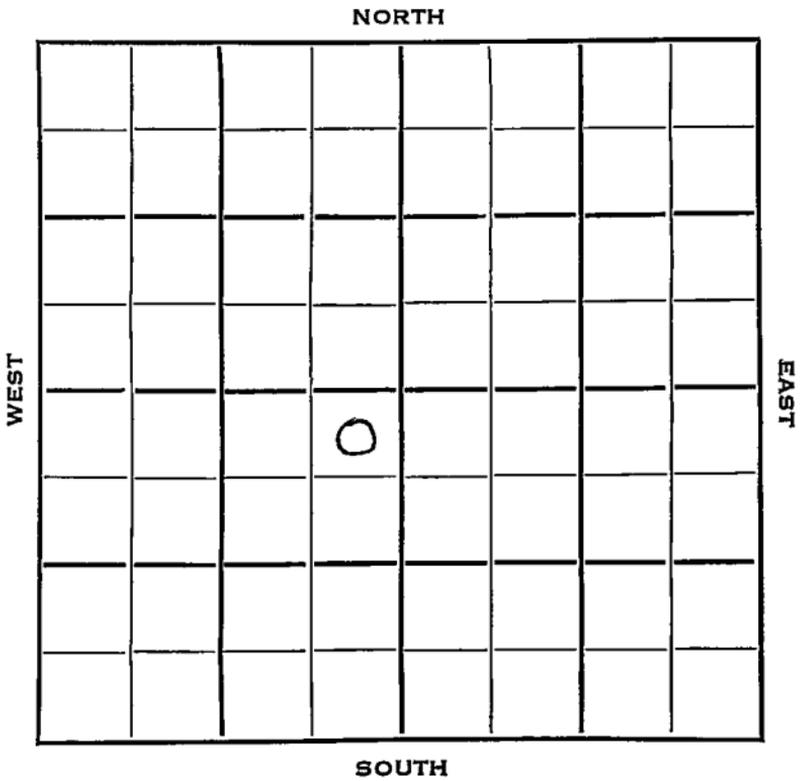

Graham KANSAS

SEC.	TWP.	R.
29	8	21 W ✓

WELL NO. _____

COMPANY # 1 Emery FARM

CONTRACTOR Peel-Hardman


Glenn Peel
Wildcat

330 _____ Ft. from N. Line

_____ Ft. from S. Line

330 _____ Ft. from E. Line

_____ Ft. from W. Line

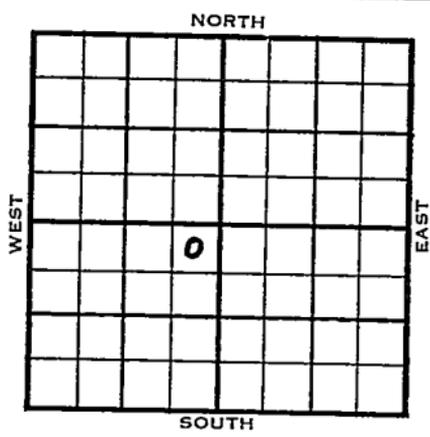

NE NE SW

	ELEVATION	REPORT
1953	2158'	

10/7	Spud 10-4-53 8" @ 157 WOC
10/14	Spud 10-4-53 D&A TD 3763' 8" @ 157 Heeb 3358, Lans 3395, B KC 3609, Cong 3730, Arb. 3740 TD 3763' D&A

ABANDONED

