

KANSAS


Sheridan

FORM 51 5M PETROL

Section 29  
~~20~~ Township 8 Range 26-W

Well No. #1 C.W. Shaeffer

Company Continental

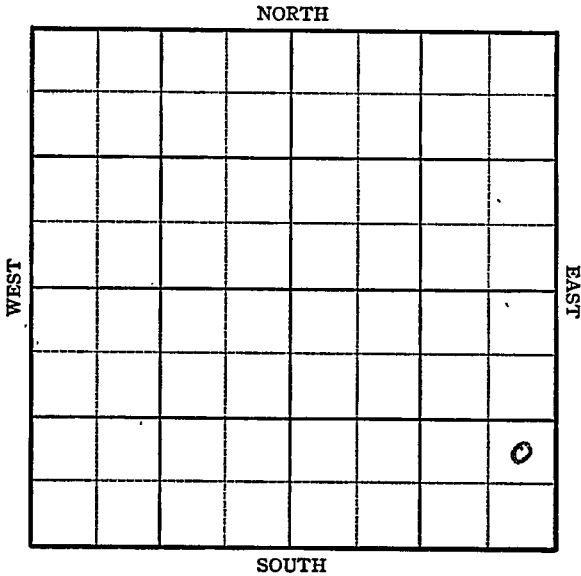

16

Sec. 29 Twp. 8 R. 26W

Well No. #1 C. W. Shaeffer Farm

Continental Company

No Name


\_\_\_\_\_ Ft. from N. Line

990 Ft. from S. Line

330 Ft. from E. Line

\_\_\_\_\_ Ft. from W. Line

NE SE SE

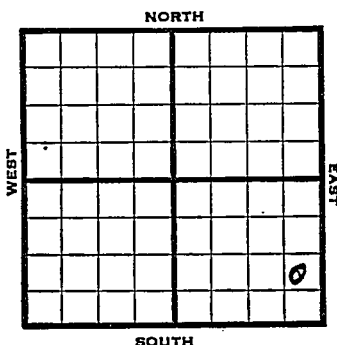

1945 Elev. 2518 REPORT

12/19 Derrick

12/29 10" - 240' WOC.

1946

1/10 Drlg. 3264'

1/14 Fsg. 3623'

1/25 " "

1/31 Lans. 3633' T.D. 3926'

Run 6"

2/7 6" - 3925' 22 shots 3780-3800'  
42 shots 3760-80' 42 shots 3740-60'  
No shows.

2/14 1500 acid with packer 3715'  
28 shots 3697-3713'  
21 shots 3690-97' 20 gals. oil & 4  
gals water per hour 6 hours.

2/20 Lans 3633  
6" @ 3925  
Perf. Lans.  
TD 3926'

**ABANDONED**

KANSAS

Kansas Pool Name No NameMap No. K-67 Sec. 29 Twp. 8 R. 26WWell No. 1 C.W. ShaefflerContinental

Company

FIRST REPORT

Contractor

NE SE SE

## SECTION PLAT

			o

       Ft. from N. Line990 Ft. from S. Line330 Ft. from E. Line       Ft. from W. LineSheridan CountyLocation       Rig up       

Drilling and Remarks:

derrick

## RECORD

Cased        in.,        ft.Sand       Gas       Oil       Total Depth       

## PRODUCTION

1st 24 hrs. Nat.       1st 24 hrs. after shot       Gas        Cu. Ft.Dry Hole       Abandoned       

Date

DEC 1 9 194719S. J. LEWISScout

