KANSAS


Rooks

FORM 51 5M 10-41 PETROL

Section 3 Township 8 Range 16-W

Well No. #1 ~~Gregory~~ Post

Company Cities Service Oil

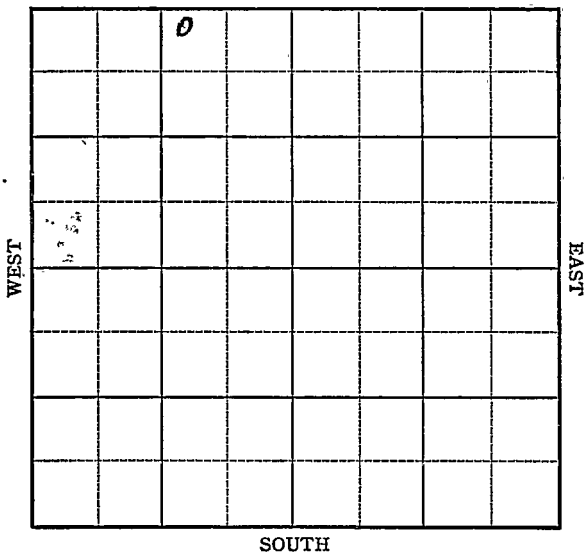

Form 252-A
5M 5-42 Petrol

# KANSAS

Rooks

Sec. 3 Twp. 8 R. 16-W

Well No. #1 ~~Gregory~~ Post Farm


Cities Service Oil Company

330 Ft. from N. Line

Ft. from S. Line

990 Ft. from E. Line

Ft. from W. Line

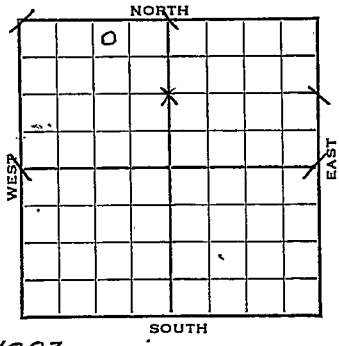


NW NE NW Elev. 1893

| 1942 | REPORT |
|---|---|
| 12/22 | Loc. |
| 12/29 | " |
| 1943 | |
| 1/6 | Rotary |
| 1/13 | 8" @ 237' WOC |
| 1/20 | Drlg. 2450'. |
| 1/27 | Anhy 12405<br>Drlg. 3320' |
| 2/3 | Topeka 2837'<br>Lans 3170<br>Congl 3529<br>Simp. 3745<br>Arb 3777<br>T.D. 3810' SD |
| 2/10 | Arb. 3777'<br>T.D. 3810'<br>No shows |

ABANDONED

Form 26 200 Bks 5-42 Petrol

Rooks

KANSAS

Map No. 64 Sec. 3 Twp. 8 R. 16W

Well No. 1 Gregory

Cities Service Oil Company

FIRST REPORT Contractor

NW NE NW

330 Ft. from N. Line


Ft. from S. Line

990 Ft. from E. Line

Ft. from W. Line

WILDCAT

SECTION PLAT

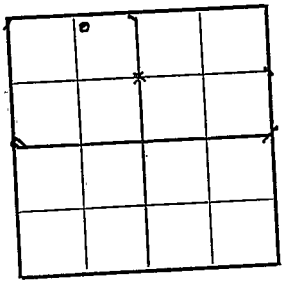

Location XXX

Rig up

Drilling and Remarks:

RECORD

Cased in., ft.

Sand

Gas

Oil

Total Depth

PRODUCTION

1st 24 hrs. Nat.

1st 24 hrs. after shot

Gas Cu. Ft.

Dry Hole

Abandoned

Date

DEC 22 1942 19

S. J. LEWIS Scout

Form 26 200 Bks 5-42 Petrol

KANSAS Rooks

Map No. 64 Sec. 3 Twp. 8 R. 16W

Well No. 1 Post

Cities Service Oil Company

CORRECTION Contractor

NW NE NW


330 Ft. from N. Line

____ Ft. from S. Line

990 Ft. from E. Line

____ Ft. from W. Line

SECTION PLAT

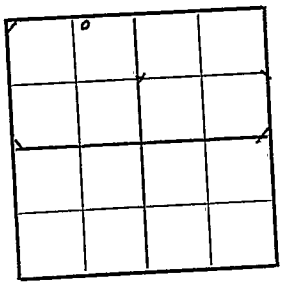

WILDCAT

Location

Rig up

Drilling and Remarks:

Reported as

#1 Gregory

RECORD

Cased ____ in., ____ ft.

Sand

Gas

Oil

Total Depth

PRODUCTION

1st 24 hrs. Nat.

1st 24 hrs. after shot.

Gas ____ Cu. Ft.

Dry Hole

Abandoned

Date

JAN 2 7 1943 19____ S. J. LEWIS Scout

Form 26 200 Bks 5-42 Petrol

Rooks KANSAS

Map No. 64 Sec. 3 Twp. 8 R. 16W

Well No. 1 Post

Cities Service Oil Company

ABANDONED Contractor

NW NE NW


330 Ft. from N. Line

____ Ft. from S. Line

990 Ft. from E. Line

____ Ft. from W. Line

SECTION PLAT

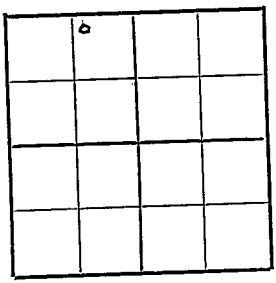

WILDCAT

Location ____

Rig up ____

Drilling and Remarks:

Cer # 8777

No Lows

RECORD

Cased ____ in., ____ ft.

Sand ____

Gas ____

Oil ____

Total Depth 3810

PRODUCTION

1st 24 hrs. Nat. ____

1st 24 hrs. after shot ____

Gas ____ Cu. Ft.

Dry Hole ____

Abandoned ____

Date

FEB 10 1943 19____

S. J. LEWIS Scout