


Graham KANSAS

DX 78-1

Section 3 Township 8 Range 24W
Well No. 4 Goff
Company E. K. Carey

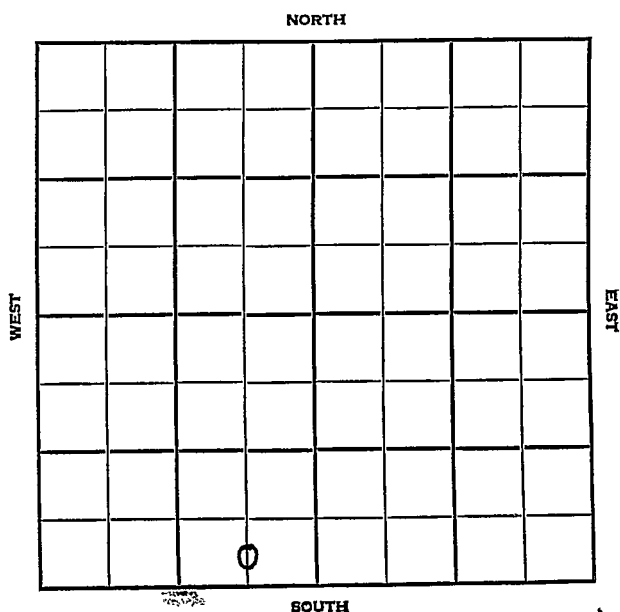

Graham KANSAS

SEC.	TWP.	R.
3	8	24W

WELL NO. FARM

4 Goff

COMPANY

E. K. Carey

CONTRACTOR

Carey

Nana Pool


_____ Ft. from N. Line

330 _____ Ft. from S. Line

660 _____ Ft. from E. Line

_____ Ft. from W. Line

C S $\frac{1}{2}$ SE SW

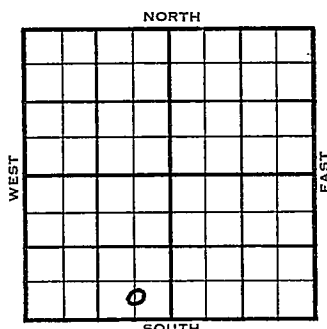

	ELEVATION	REPORT
1954	2309'	

~~7/14~~
~~8/14~~ Spudding 7-8-54
Drlg. 1821

7/21 8" @ 129
Drlg. 2950'

8/4 Spud 7-8-54
Oil Well
TD 3775'
8" @ 129'
Heeb 3507', Lans 3529'
DST 3560-3601', opn 1 hr., rec. 1680'
gas, 472' oil, 1300#
DST 3599-3635', opn 1 hr., rec. 180'
gas, 300' oil, 1180#
DST 3679-3713', opn 1 hr., rec. 1290'
gas, 300' oil, 920#
DST 3714-47, opn 1 hr., rec. 900' gas,
240' oil, 1000#
B KC 3754'
TD 3775'
4 $\frac{1}{2}$ " @ 3774'
CO to 3750
24/3706-13, 24/3688-95
FU 1860' oil 12 hrs., 3000A
S/23 boph
Comp. 432 bopd

J. G. McGEHEE

J. G. McGEHEE