


DX 78-1 Graham

KANSAS

Section 3 Township 8 Range 24W

Well No. #1 Evans

Company R. W. Shields - Empire - Barnett Drlg

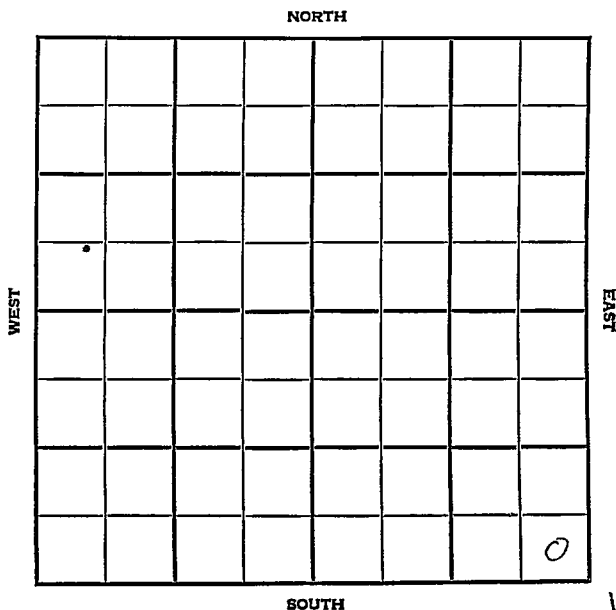

16.

Graham

KANSAS

SEC. 3	TWP. 8	R. 24W
-----------	-----------	-----------

WELL NO. #1 Evans FARM

COMPANY R.W. Shields - Empire - Barnett Drlg.

CONTRACTOR Empire

Nana


_____ FT. FROM N. LINE

_____ FT. FROM S. LINE

_____ FT. FROM E. LINE

_____ FT. FROM W. LINE

SE SE SE

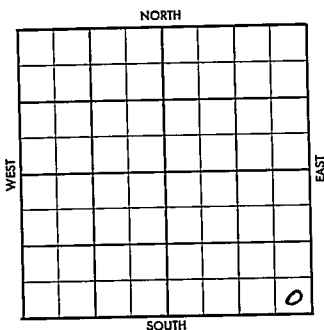

1956	ELEVATION	REPORT
	2349'	

7-18 8" @ 175 w/125
Drlg. 3652
Anh. 1991'; H. 3572';

7-25 DST 3629-49 op 1 hr, rec. 150' SW,
FP 30-60#, BHP 1090/20".
DST 3738-64 op 30 min, rec. 15' mud,
BHP 30/20"; RTD 3840';
No Log.
D & A
L. 3611';
TD 3840'

ABANDONED

County Graham Elev. 2349
 Sec. 3 Twp. 8 Rgs. 24W
 Company R.W. Shields - Empire - Barnett Drlg.
 Farm Name Evans No. 1

TOPS	DEPTH	LOG	DATUM
Anh.	1991		
TP.			
H.	3572		
Tr.			
Dg.			
Bl.			
L.			
K.C.			
B.K.C.			
Ce.			
C.			
M.			
M.			
K.			
Mz.			
Mo.			
V.			
S.			
S.			
A.			
R.			
PE.			
G.			
T.D.			

Loc. in Sec. SE SE SE
 Geol. _____
 Contr. Empire
 Pool Nana

FIRST REPORT

JUL 18 '56

Date Comm. 8" @ 175/125 drlg. 3652



TOPS	DEPTH	LOG	DATUM	Loc. in Sec.
Anb.	1991			2 7 S
Tr.				
H.	3572			
Tr.				
Dg.				
Bl.				
L.	3611			Geol.
K.C.				Contr.
B.K.C.				Tyiro
Ce.				
C.				
M.				Pool
M.				
K.				
Mz.				
Mo.				
V.				
S.				
S.				
A.				
R.				
PE.				
G.				
TD.	3840			

ABANDONED
 JUL 25 1956

Date Comm. 8" @ 175/125 drlg. 3652 JUL 25 '56 X L59
3611 DST ~~3611~~-3629-49 op 1
hr. rec. 150' SW FP 30-60
BHP 1090/20" DST 3738-64
op 30" rec 15' MD BHP 30/20"
RTD 3840 NO LOG
D & A

Co.
 L.S.
 No.
 Sec.
 T.
 R.