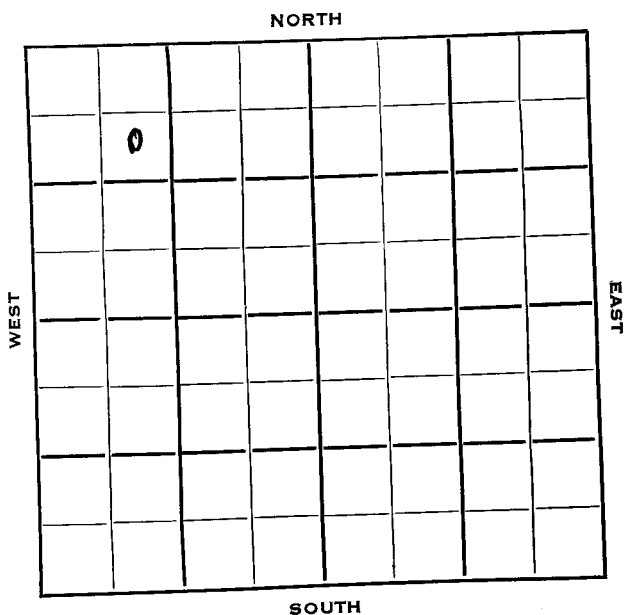


Section 30 Township 8 Range 17 WWell No. # 2 BirdCompany D. C. Hansen

|              |      |        |
|--------------|------|--------|
| Rooks        |      | KANSAS |
| SEC.         | TWP. | R.     |
| 30           | 8    | 17 W   |
| WELL NO.     |      |        |
| # 2 Bird     |      | FARM   |
| COMPANY      |      |        |
| D. G. Hansen |      |        |
| CONTRACTOR   |      |        |
| C & G Drlg.  |      |        |

Dopita Pool


990 Ft. from N. Line

Ft. from S. Line

Ft. from E. Line

990 Ft. from W. Line

SE NW NW

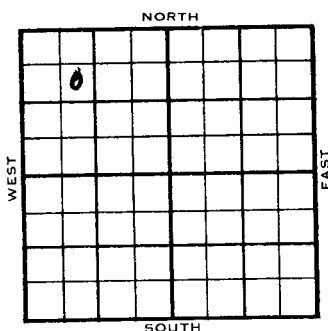

|       | ELEVATION             | REPORT                  |
|-------|-----------------------|-------------------------|
| 1953  | 1987'                 |                         |
| 11/24 | MIR                   |                         |
| 12/16 | CO                    |                         |
| 1954  |                       |                         |
| 1/27  | Spud 11-24-53         | Oil well TD 3409        |
|       | 8-5/8" @ 163          | Top. 2888' Heeb 3101    |
|       | Tor. 3121             |                         |
|       | DST 3106-37           | open 1 hr rec 140' HO & |
|       | GCM, 10' oil, 1060#   |                         |
|       | Lans. 3142'           |                         |
|       | DST 3289-3303,        | open 1 hr rec 300' gas, |
|       | 30' MCO, 5" free oil  | 1050#                   |
|       | B KC 3367' Arb. 3401' | TD 3408                 |
|       | 5" @ 3405             | CO to 3408 DD 3409      |
|       | S/14 BOPH 750A        | S/20 BOPH 2 hr.         |
|       | Comp. 240 BOPD        |                         |

COMPLETED

County **Rooks** State **Kansas**  
 Sec. **30** (Blk.) **8** (Sur. Rge.) **17W** Map No.  
 Operator **D. G. Hansen**  
 Well No. **2** Farm **Bird**  
 Elev. Location **SE NW NW**

|  |   |  |  |  |  |  |  |
|--|---|--|--|--|--|--|--|
|  |   |  |  |  |  |  |  |
|  | o |  |  |  |  |  |  |
|  |   |  |  |  |  |  |  |
|  |   |  |  |  |  |  |  |
**FIRST REPORT**

**990 Ft. From N Line NW**  
**990 Ft. From W Line Quarter**  
 1st. Report **2 4 12**  
 Completion  
 Remarks  
**C & G Drlg. - Contr.**  
 Spudding Date

Drlg. Data

**Dopita Pool****N I R**

County \_\_\_\_\_ Rocks \_\_\_\_\_ State Kansas  
 Sec. 30 (Blk.) 8 (Sur.) 17W Map No. \_\_\_\_\_  
 Operator D. G. Hansen  
 Well No. 2 Farm Bird  
 Elev. 1987 Location SE NW NW

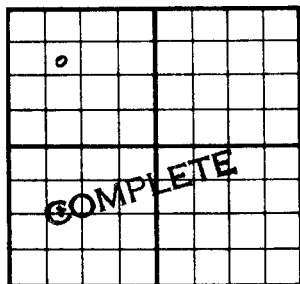

990 Ft. From N Line NW  
 990 Ft. From W Line Quarter

1st. Report \_\_\_\_\_

Completion JAN 27 1954

Remarks Dopita Pool

C & G Drlg. - Contr.

Spudding Date 11-24-53

Drlg. Data Oil well TD 3409

8 5/8" C 163 Top. 2888 Heeb. 3101

Ter. 3121 DST 3106-37 open 1 hr.

Rec. 140' ho & gem 10' oil 1060#

Lans. 3142 DST 3239-3303 open 1 hr.

Rec. 300' gas 30' mco 5" free oil

1050# B KC 3367 Arb. 3401 TD 3408

5" C 3405 CO to 3408 DD 3409

S/ 1 1/2 bopd 750A S/ 20 bopd 2 hr.

Comp. 240 bopd

J. G. McDaniel