


Rooks

Section 30 Township 8 Range 17-W

Well No. #1 Elsie

Company Phillips & Continental

Dopita Pool

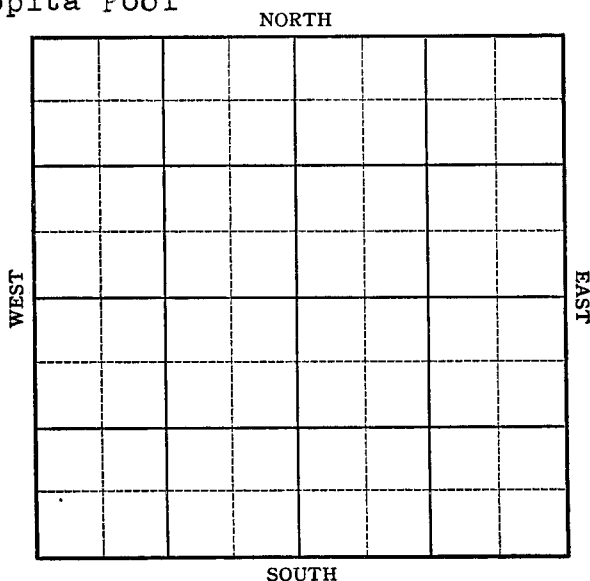

W 17-34 S

Rooks

Sec. 30 Twp. 8 R. 17-W

Well No. #1 Elsie Farm
Phillips & Continental Company

(Dopita Pool)


 Ft. from N. Line

660 Ft. from S. Line

660 Ft. from E. Line

 Ft. from W. Line

Elev. 1984

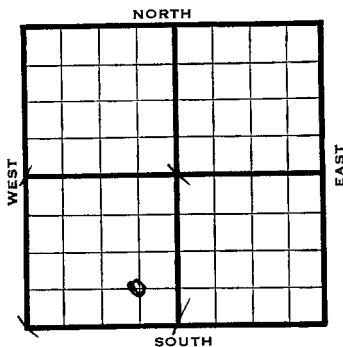

1942

REPORT

9/9

Rotary.

9/16

Annly 121 8" @ 1303 Drlg 1986

9/23

Lans. 3140

Arb. 3453

No shows

TD 3485

Re 125

Map No. 64 Sec. 30 Twp. 8 R. 17WWell No. 1 ElsiePhillips & Continental CompanyABANDONED

Contractor

C 31 31

SECTION PLAT

	0		

 Ft. from N. Line600 Ft. from S. Line600 Ft. from E. Line Ft. from W. Line

DOPITA POOL

Location Rig up

Drilling and Remarks:

Lane 3140Cr 8.3453No show

RECORD

Cased in., ft.Sand Gas Oil Total Depth 3485

PRODUCTION

1st 24 hrs. Nat. 1st 24 hrs. after shot Gas Cu. Ft.Dry Hole Abandoned

Date

SEP 23 1942

19


S. J. LEWIS

Scout

Map No. 64 Sec. 30 Twp. 8 R. 17WWell No. 1 ElsiePhillips & Continental Company**FIRST REPORT**

Contractor

C SE SW

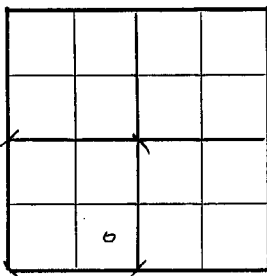SECTION PLAT Ft. from N. Line660 Ft. from S. Line660 Ft. from E. Line Ft. from W. LineDOBITA POOLLocation Rig up

Drilling and Remarks:

Rotary

RECORDCased in., ft.Sand Gas Oil Total Depth **PRODUCTION**1st 24 hrs. Nat. 1st 24 hrs. after shot Gas Cu. Ft.Dry Hole Abandoned

Date

SEP 9 1942 19 S. J. LEWIS Scout