


Section 30 Township 8 Range 17W

Well No. 1 Kenny

Company Harwood & Stickel

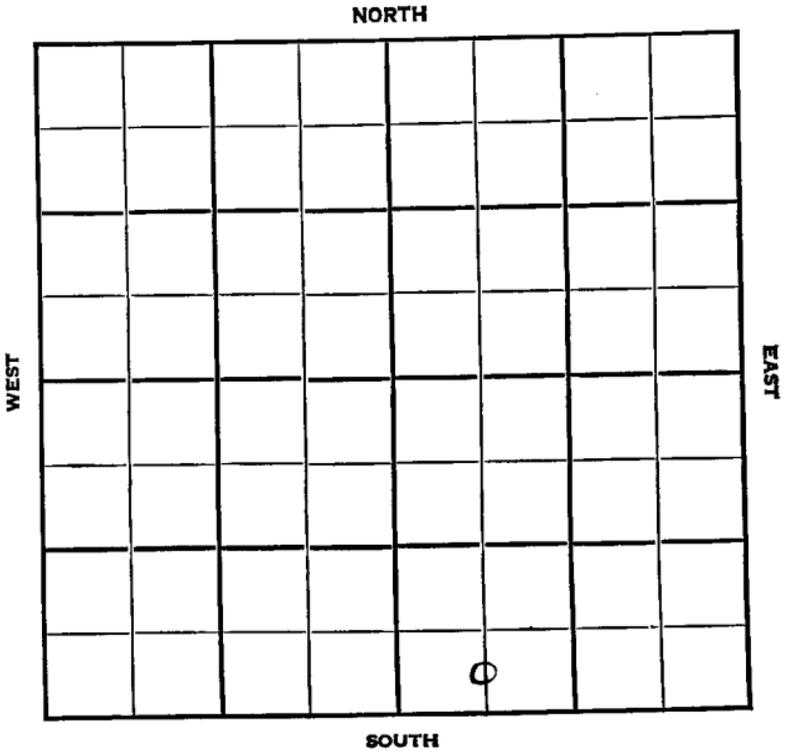

Sec. 30 Twp. 8 R. 17W


Well No. #1 Kenney Farm
Harwood & Stickel Company
Wildcat

 Ft. from N. Line

330 Ft. from S. Line

 Ft. from E. Line

660 Ft. from W. Line

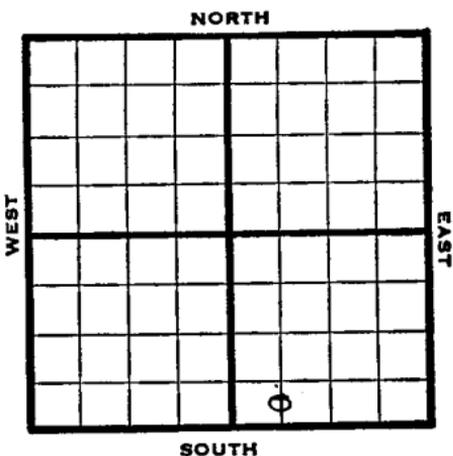

C S L SW SE

1948 Elev. 1.36' REPORT

4/28 Location

5/5 8" @ 207'
WOC

5/11 Drlg. 3004'

5/19 Lansing 3095'
Arbuckle 3361'
TD 3385'
SO
5" @ 3385'
RUST

6/1 Arbuckle 3361'
5" @ 3385'
Perf.
Acid 1,500
Pump 17 oil Pot.
Gr. 27°
TD 3385'

COMPLETED

Map No. _____ Sec. 30 Twp. 8 R. 17W

Well No. 1 Kenney

Harwood & Stickel Company

FIRST REPORT

Contractor

C S L SW SE

SECTION PLAT

_____ Ft. from N. Line

330 _____ Ft. from S. Line

_____ Ft. from E. Line

660 _____ Ft. from W. Line

Rooks County

Location x

Rig up _____

Drilling and Remarks:

RECORD

Cased _____ in., _____ ft.

Sand _____

Gas _____

Oil _____

Total Depth _____

PRODUCTION

1st 24 hrs. Nat. _____

1st 24 hrs. after shot _____

Gas _____ Cu. Ft.

Dry Hole _____

Abandoned _____

Date

APR 28 1948 19

S. J. LEWIS Scout

Map No. 64 Sec. 30 Twp. 8 R. 17W

Well No. 1 Kenney

Harwood & Stichel Company

COMPLETE

Contractor

C S L SW SE

E 11985

SECTION PLAT

_____ Ft. from N. Line

330 Ft. from S. Line

_____ Ft. from E. Line

660 Ft. from W. Line

Rooks County

RECORD

Location _____

Cased _____ in., _____ ft.

Rig up _____

Sand _____

Drilling and Remarks:

Gas _____

Oil _____

Total Depth 3385

Art # 3361

5' 3385'

Perf.

1500000 C

Pump 17 oil 6 P & D

27 2/3

PRODUCTION

1st 24 hrs. Nat. _____

1st 24 hrs. after shot _____

Gas _____ Cu. Ft.

Dry Hole _____

Abandoned _____

Date

JUN 1 1948 19

S. J. LEWIS Scout