

Rooks


DX 78-1

KANSAS

Section 30 Township 8 Range 17W

Well No. #1 Schneider

Company C & G Drlg.

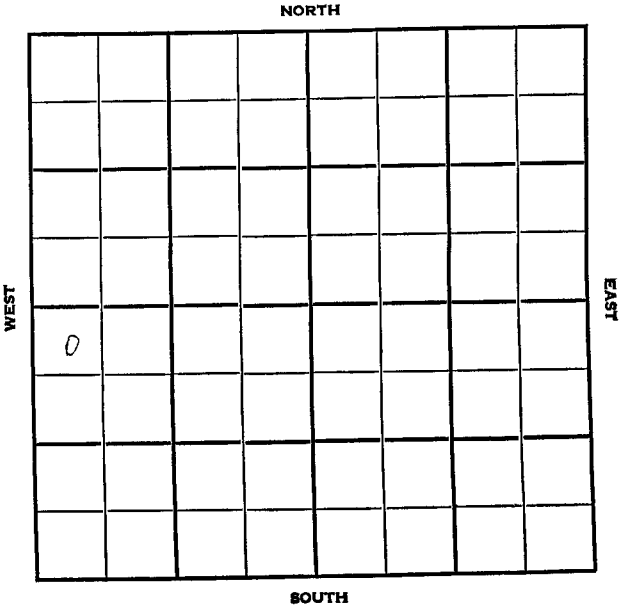

Rooks


SEC.	TWP.	R.
30	8	17 W

WELL NO. # 1 Schneider FARM

COMPANY C & G Drlg.

CONTRACTOR C. & G. Drlg.

Dopita Pool
 330 Ft. from N. Line
 Ft. from S. Line
 Ft. from E. Line
 330 Ft. from W. Line

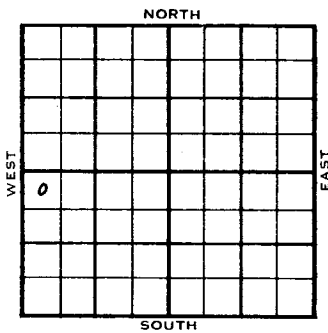

NW NW SW

	ELEVATION	REPORT
--	-----------	--------

1954	1990'	
9/8	Spud 8-31-54 8" @ 177 Anhy 1310 Drlg. 2000'	
9/15	Spud 8-31-54 D & A TD 3430 8" @ 177 Anhy 1310' Heeb 3110 1" or. 3130 Lans 3151 DST 3318-32 open 1 hr rec 1881' 0 & GCSW 990# B KC 3379 Arb. 3410 DST 3411-17 open 3/4 hr rec 12' mud 690# DST 3417-24 open 1/2 hr. rec 284' mud 545# DST 3424-30 open 1/2 hr rec 15' mud 0# TD 3430 D & A	

ABANDONED

