


Section 30 Township 8 Range 23W

Well No. 1 Gaylord

Company C & G Drlg. & D. G. Hansen

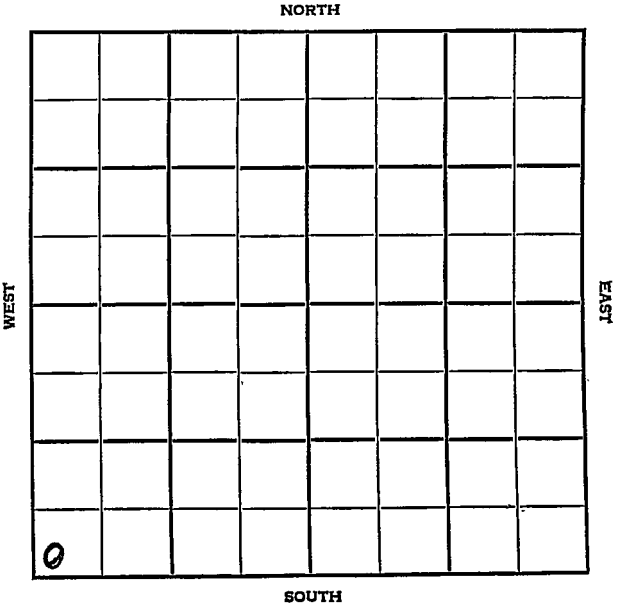

Graham

KANSAS

SEC.	30	TWP.	8	R.	23W
------	----	------	---	----	-----

WELL NO.

I Gaylord

FARM

COMPANY

C & G Drlg & D. G. Hanson

CONTRACTOR

C & G Drlg


Wildcat

_____ Ft. from N. Line

_____ Ft. from S. Line

_____ Ft. from E. Line

_____ Ft. from W. Line

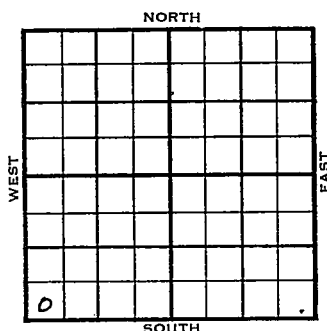

SW SW SW

1 mi S D-X

1955	2342' DF 2345' RB	REPORT
6/29	Location	
7/7	Spud 6-29-55 8-5/8" @ 295 w/200 Anhy 2033' Drlg. 3455'	
7/13	Comm. 6-29-55 8-5/8" @ 295 w/200 DST 3735-50 open 1 hr rec 6' mud 0/20" DST 3758-76, open 1 hr rec 100' mud, spk oil, 50' wtry mud, 1355/15" DST 3820-56, open 1 hr rec 15' mud 840/20" DST 3856-70 open 1 hr rec 35' mud. 1155/20" D & A Tops: Depth Anh 2033 H. 3653' Tr. 3675' KC 3696' BKC 3914 C. 4020' M. Ch. 4161' A 4224' TD 4272' D & A	

ABANDONED

County Graham Elev. _____
 Sec. 30 Twp. 8 Rge. 23W
 Company C & G Drig. & D. G. Hansen
 Farm Name Gaylord No. 1

TOPS	DEPTH	LOG	DATUM	Loc. in Sec. _____
Anh.				SW SW SW
Tr.				
H.				
Tr.				
Dg.				
BL.				
L.				Geol. _____
K.C.				Contr. _____
B.K.C.				<u>C & G Drig.</u>
Ce.				Pool _____
C.				<u>Wildcat</u>
M.				
M.				
K.				
Mz.				
Me.				
V.				
S.				
S.				
A.				
R.				
Pe.				
G.				
T.D.				

1 mile
 FIRST REPORT
 JUN 29 1955
 0

Date Comm. _____
 Location _____

S

Co.

Lse.

No.

Sec.

T.

R.

2342 DF

2345 RB

County Graham Elev. 2345 RBSec. 30 Twp. (8) Rge. 23WCompany C & G Drlg. & D. G. HansenFarmName Gaylord No. 1

TOPS	DEPTH	LOG	DATUM	Loc. in Sec.
Anh.	2033			SW S WSW
Tr.	3653		1308	
Dg.	3675		1330	
BL.				
L.				
K.C.	3696		1351	Geol.
B.K.C.	3914		1569	Contr.
Ce.				
C.	4020		1675	C & G Drlg.
M. C.V.	4161		1816	
M.				Pool
K.				Wildcat
Mz.				
Ma.				
V.				
S.				
S.				
A.	4224		1879	
R.				
P.E.				
G.				
T.D.	4272		1930	

Date Comm. 6-29-55

JUL 13 1955

8 5/8" @ 295/200 DST 3735-50 open 1 hr.

Rec. 6' mud 0/20" DST 3758-76

open 1 hr. Rec. 100' mud spk oil 50'

wtry mud 1335/15" DST 3820-56

open 1 hr. Rec. 15' mud 840/20"

DST 3856-70 open 1 hr. Rec. 35' mud

1155/20"

D & A