

Thomas

KANSAS

SECTION 30 TOWNSHIP 8 RANGE 32W

WELL NO. #1 Kindig

COMPANY Bachus Oil & Veeder Supply

NORTH

							0

WEST

EAST

SOUTH

9

SEC.	TWP.	R.
30	8	32W

WELL NO.

#1 Kindig

FARM

COMPANY

Bachus Oil & Veeder Supply.

CONTRACTOR

Veeder

WILDCAT


_____ Ft. from N. Line

_____ Ft. from S. Line

_____ Ft. from E. Line

_____ Ft. from W. Line

NE NE SE

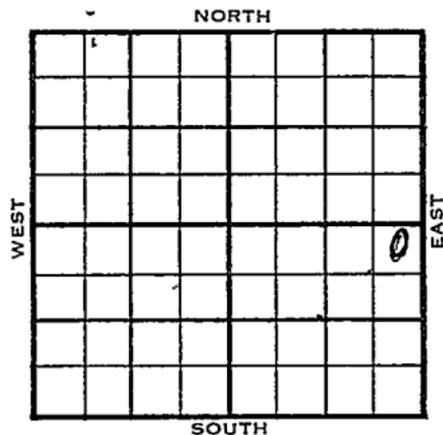

Carter AC & DHM

	ELEVATION	REPORT
1956	3132 RB, 3127 GF	
4-25	Comm. 4-19-56 8" @ 304 w/175 Drlg. 3900 Anh. 2720	
5-20	DST 3993-4015, op 1 hr, rec 130' mud BHP 1190/ 20" DST 4030-47, op 55 min, Pkr failed, rec. 450' mud Hb. 4074', Tr. 4092', Lsg.-K.C. 4114', DST 4114-85, op 1 hr, rec 115' mud BHP 1200/ 20" B.K.C. 4424,	
5-9	Marm 4446' DST 5430-37, op 65 min, rec 55' socm BHP 190/ 20" DST 4595'-4626, op 1 hr, 800' gas, rec. 1690' GCO / 150' mdy oil FP 130-700; BHP 1170# DST 4633-54, op 37 min, rec 7' mud BHP 40/ 20" DST 4684-4718, op 49 min, rec 30' mud BHP 420/ 20" 5 1/2" @ 4665 w/150	
5-16	CO, FP 16/ 4608-12 8 boph, no/wtr. 600' O.B. crnl	

(Information continued)

1956

5-16

Putting on pump

P/ 363 bo in 28 hrs., no/wtr .

6-20

P/ 401 bopd, no/wtr.

grav. 26°

How. 3862', Tp. 3896', Marm 4426',

Ce. 11554', M. 4679',

Log: Marm 4449', Ce. 4648',

M. 4682',

TD 4780'

COMPLETED

3132 RB

County Thomas Elev. 3127 GF

Sec. 30 Twp. 8 Rge. 3 2W

Company Bachus Oil & Veeder Supply

FarmName Kindig No. I

TOPS	DEPTH	LOG	DATUM
Anh.	2720		
Tp.			
H.			
Tr.			
Dg.			
Bl.			
L.			
K.C.			
B.K.C.			
Ce.			
C.			
M.			
M.			
K.			
Mz.			
Mo.			
V.			
S.			
S.			
A.			
R.			
PE.			
G.			
T.D.			

Loc. in Sec. NE NE SE

Geol. _____
Contr. Veeder

Pool Wildcat

FIRST REPORT

APR 25 '56

Date Comm. 4-19-56 Carter AC & DHM

8" @ 30h/175 drlg. 3900

Handwritten signature/initials

APR 1956

APR 1956

o

Co.
Lsc.
No.
Sec.
T.
R.

FORM 513 SUNRAY

3132 RB

County Thomas Elev. 3127 GFSec. 30 Twp. 8 Rge. 3 2WCompany Bachus Oil & Veeder SupplyFarm Name Kindig No. 1

TOPS	DEPTH	LOG	DATUM	Loc. in Sec.
Anb.	2720			NE NE SE
Ip.				
H. <u>How</u>	<u>3862</u>			
Tr. <u>TR</u>	<u>3896</u>			
Dg.				
Bl.				
L.	<u>4114</u>	<u>4114</u>		Geol.
K.C.				Contr.
B.K.C. <u>Marm</u>	<u>4426</u>	<u>4449</u>		Veeder
Ge.	<u>4554</u>	<u>4648</u>		
C.				Pool
M.	<u>4679</u>	<u>4682</u>		
M.				
K.				
Mz.				
Mo.				
V.				
S.				
S.				
A.				
R.				
Pe.				
G.				
TD.	<u>4780</u>			

COMPLETE

JUN 20 1956

Date Comm. 4-19-56 Carter AC & DHM" 8" @ 30lb/175 drlg. 3900 MAY 2 '56DST 3993-4015 1hr rec 130'Md 1190/20" DST 4030-47 55"PKY Failed Rec 450' Md H64074 TR 4092 L59-Kc 4114DST 4144-85 1hr rec 115' Md1200/20 BKC 4424 Marm 4426Ø 4480 MAY 9 '56 Marm 4446 DST4530-37 op 65" rec 55' SOCM.

28-9-3-VV

NE NESE

BHP 190/20" DST 4595-4626

op 1 hr 800' gas rec. 1690' GCO

+ 150' Md oil FP 130-700 BHP

1170/ # ~~2nd~~ ~~DST 4595-4626~~ #7

DST 4633-54 37" rec. 7' Md

BHP 40/20" DST 4684-4718

49" rec 38' Md BHP 420/20"

5 1/2 @ 4665/150 MAY 18 '56 CO

PF 16/4608-12 & 8 Boph no/w

600' O.B. CRNL 1 1/2 POP

P. 363 Boin 28 hrs no/wtr.

MAY 23 '56 MAY 29 '56 JUN 6 '56 JUN 13 '56 JUN 20 '56

Ph P. 401 Bopd no/wtr.

gas 26"