

KANSAS Rooks

Section 31 Township 8 Range 18WWell No. 1 AndresonCompany A.L. Derby Drlg.

Chandler Pool

NORTH

WEST

EAST

SOUTH

KANSAS

Rooks

✓
18W

Sec. 31 Twp. 8 R. 18W

Well No. #1 Anderson Farm

A. L. Derby Drlg. Company


Chandler Pool

 Ft. from N. Line

330' Ft. from S. Line

 Ft. from E. Line

990' Ft. from W. Line

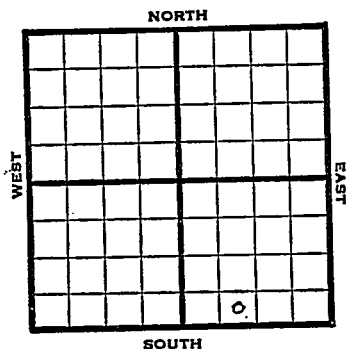

SE SW SE

Elev. 2050' REPORT

1948

10/27	8" @ 162'	
	Drlg. 1930'	
11/3	Lansing 3128'	
	Arbuckle 3484'	
	TD 3488'	
	5" @ 3488'	
11/10	500 acid	
11/16	500 acid swb 5 bbls fluid PH	
	40% W	
	TD 3491'	
11/23	"	
11/30	500 acid	
	1 1/2 barbers fluid PH	
	50% W	
12/8	"	
12/15	"	
12/22	"	
12/29	"	
1/5	"	
1/12	"	
1/19	"	
1/26	Lans. 3128'	Arb 3484'
	5" @ 3488'	
	1000 acid	
	Pump 36 oil & 24 W Pot.	
	17° Gr	
	TD 3491'	

COMPLETED

Chandler Pool

Map No. _____ Sec. 31 Twp. 8 R. 18W

Well No. 1 Andreson

A. L. Derby Drlg. Company _____

FIRST REPORT Contractor _____

SE SW SE

SECTION PLAT

_____ Ft. from N. Line

330 Ft. from S. Line

_____ Ft. from E. Line

990 Ft. from W. Line

Rooks County

Location _____

Rig up _____

Drilling and Remarks:

8" @ 162

drlg. 1930

RECORD

Cased _____ in., _____ ft.

Sand _____

Gas _____

Oil _____

Total Depth _____

PRODUCTION

1st 24 hrs. Nat. _____

1st 24 hrs. after shot _____

Gas _____ Cu. Ft.

Dry Hole _____

Abandoned _____

Date

OCT 27 1948

S. J. LEWIS Scout

Map No. 64 Sec. 31 Twp. 8 R. 18W

Well No. 1 Andreson

A. L. Derby Drlg.


Company

COMPLETE

Contractor

SE SW SE

E. 2050
SECTION PLAT

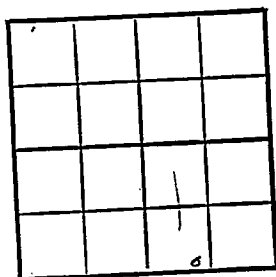

 Ft. from N. Line

330

 Ft. from S. Line

 Ft. from E. Line

990

 Ft. from W. Line

Rooks County

Location

Rig up

Drilling and Remarks:

Liam 3125

Per 8 484

5 " 03485

1000 acia 6

Pump 36 oil + 24W

Per 27 2/2

RECORD

Cased in., ft.

Sand

Gas

Oil

Total Depth 3491

PRODUCTION

1st 24 hrs. Nat.

1st 24 hrs. after shot

Gas Cu. Ft.

Dry Hole

Abandoned

Date

JAN 26 1949

19

S. J. LEWIS

Scout