


SECTION 31 TOWNSHIP 8 RANGE 18W

WELL NO. #1 Anderson

COMPANY Cook & Galloway & Oil Trading

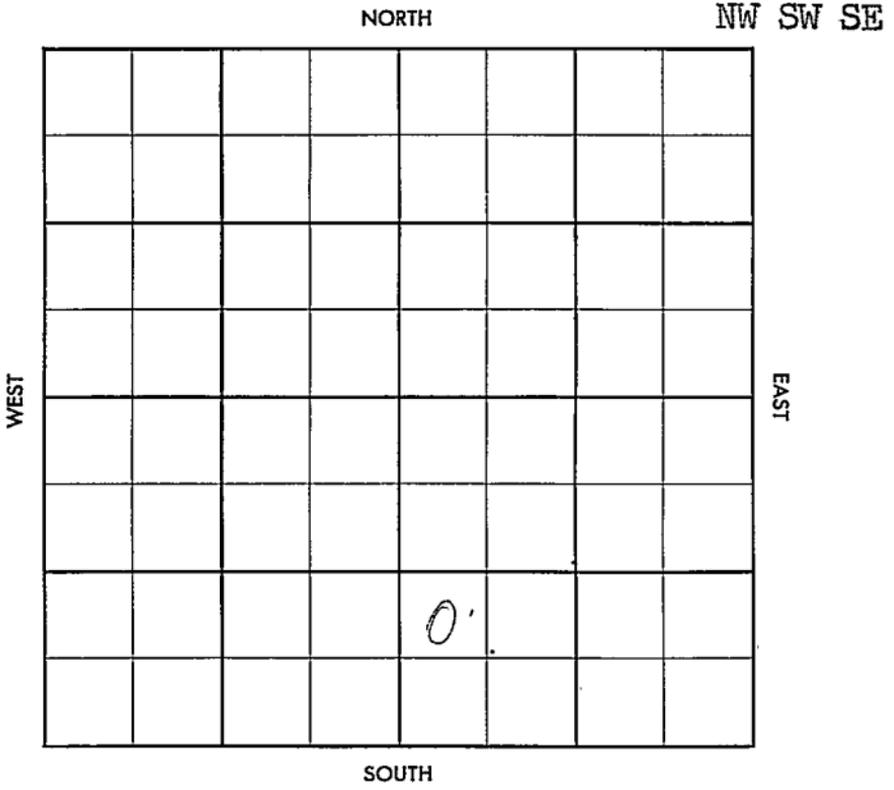

County Rooks Elev. _____
 Sec. 31 Twp. 8 Rge. 18W
 Company Cook & Galloway & Oil Trading
 Farm Name Anderson No. 1

TOPS	DEPTH	LOG	DATUM	Loc. in Sec.
Anh.	<u>7435</u>			NW SW SE
Tr.				
H.				
Tr.				
Dg.				
Bl.				
L.				Geol. _____
K.C.				Contr. <u>Cook &</u>
B.K.C.				<u>Galloway Tool</u>
Ce.				Pool _____
C.				
M.				
M.				
K.				
Mz.				
Ma.				
V.				
S.				
S.				
A.				
R.				
Pe.				
G.				
T.D.				

APR 24 57
 FIRST REPORT
 T

Date Comm. 4-20-57
8" @ 180/135, Drlg. 2320

Co.
 L&S
 No.
 Sec.
 T.
 R.

County Rooks Elev. 2046
 Sec. 31 Twp. 8 Rge. 18W
 Company Cook & Galloway & Oil Trading
 FarmName Anderson No. 1

TOPS	DEPTH	LOG	DATUM	Loc. in Sec.
Anh.	1435			NW SW SE
TP.				
H.	3149			
Tr.	3216			
Dg.				
Bl.				
L.				Geol.
K.C.	3234			Contr. Cook &
B.K.C.	3453			Galloway Tool
Ce.				Pool
C.				
M.				
M.				
K.				
Mz.				
Ma.				
V.				
S.				
S.				
A	3487			ABANDONED
R.				
PE.				
G.				
TD.	3507			



Date Comm. 4-20-57
8" @ 180/135, Drlg. 2320 @ 1 57 DST
3304- 25' or 30" 480' MSW
+ scum oil BHP 1070

DEA

Co.
 L.S.
 No.
 Sec.
 T.
 R.