


Section 31 Township 8 Range 17W

Well No. #4 Russ

Company Peel-Hardman Producers

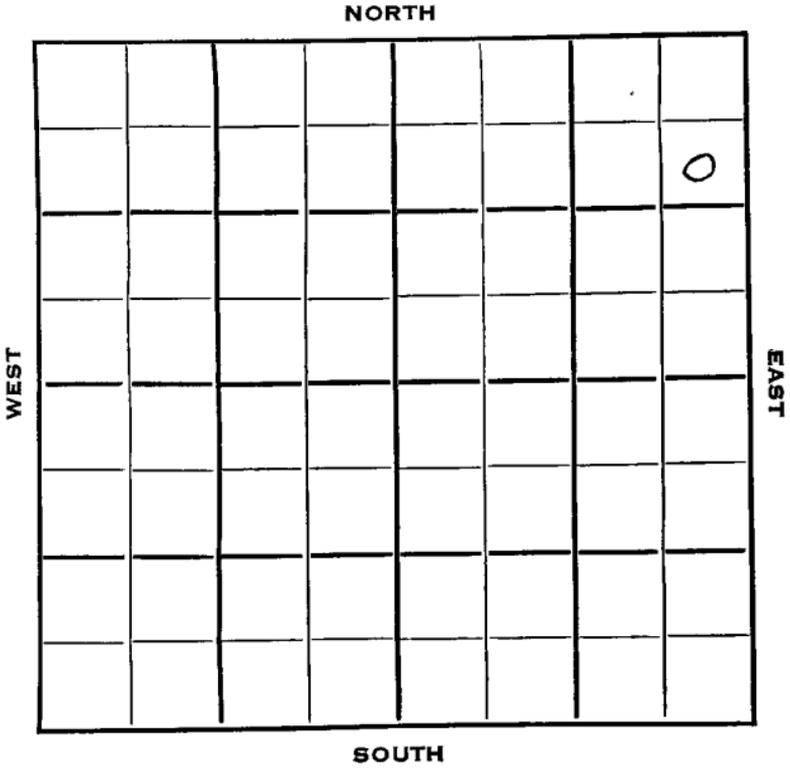

Rooks

KANSAS

SEC.	TWP.	R.
31	8	17W ✓

WELL NO.

4 Russ

FARM

COMPANY

Peel-Hardman Producers

CONTRACTOR

Peel Bros.


Dopita Pool

990 Ft. from N. Line

Ft. from S. Line

330 Ft. from E. Line

Ft. from W. Line

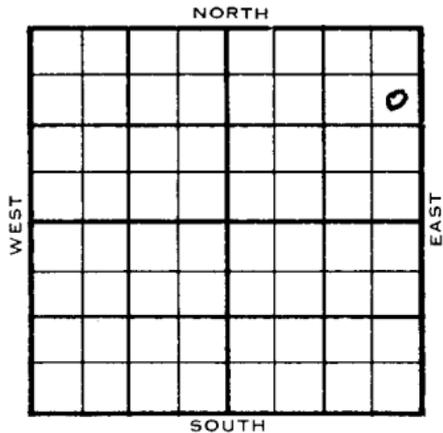

SE NE NE

1953

ELEVATION

1922'

REPORT

11/4

Cellar & Pits

11/11

"

11/18

8" @ 200 w/135 Anhy 1250
Drlg. 2190'

1954

1/6

Spud 11-10-53 Oil well TD 3350
 8" @ 200 Heeb 3024 Lans 3069
 DST 3159-78 open 3/4 hr, rec 650'
 OCSW 890#
 DST 3261-95 open 3/4 hr, rec 90' gas,
 40' OCM 690# Arb. 3344
 TD 3350 5" @ 3347 CO to 3350
 1500 A S/5 BOPH
 Comp. 25 BOPD

COMPLETED

