

KANSAS

Rooks


Form 51-5M-7-39-Palace

Section 31 Township 8 Range 17-W

Well No. #2 Dopita

Company K. A. Nill

NORTH Dopita Pool

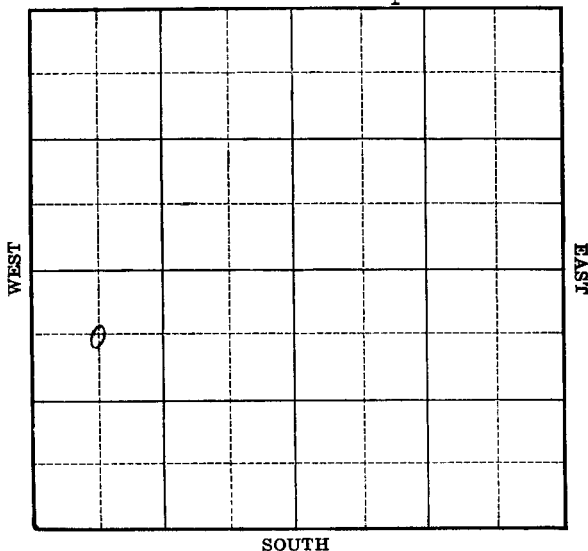

Sec. 31 Twp. 8 R. 17-W

Well No. 2 Dopita Farm

K. A. Mill Company

Dopita)


660 Ft. from N. Line

\_\_\_\_\_ Ft. from S. Line

\_\_\_\_\_ Ft. from E. Line

660 Ft. from W. Line

Elev. 2006

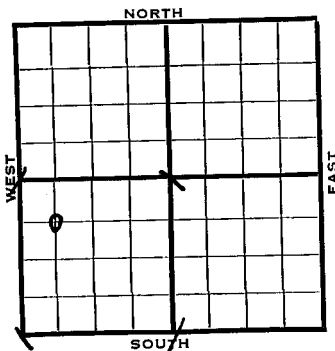

	REPORT
1940	
6/26	Spud - Cable.
7/3	" "
7/10	Drlg. 310'
7/18	15" - 310' 12" - 640'
	Drlg. 650'
7/25	Drlg. 1025'
8/2	10" - 1055' Laby 1006'
	1319' U.R. 10".
8/8	10" - 1315' Drlg. 1940'
8/14	8" @ 2340'
	2355 S.D.
8/22	8" - 2415' Drlg. 2435'
8/29	Drlg. 2785'
9/5	Topeka 2900' T.D. 2955'
	Run 6".
9/12	Drlg. 3100'
9/19	7" - 3060' Laby. 3168'
	Drlg. 3150' No shows.
9/26	Laby. 3168' (Corrected)
	T.D. 3174' U.R. 7".

OVER

- 1940
- 10/3 S.O. 3207-08' SO 3250-53'  
Drlg. 3254'
- 10/10 7" - 3263' Pwy 3297-3300' T.D.  
1 bbl. oil per hour.
- 10/17 T.D. 3329' 300' oil.  
7" - 3294' P.B.P.
- 10/24 2000 acid. Pump 110 oil & 36  
water 18 hours.
- 10/31 Pump 76 oil & 210 water 48 hrs.
- 11/7 T.D. 3352½' Swab 33 oil & 60  
water.
- 11/14 Shut down.
- 11/21 Arb. ~~3350-3355~~' T.D. 2700' fluid  
10% oil.
- 11/27 TD 3405' H.F. Fluid,
- 12/5 Drilling 3411' says not in Arb.
- 12/12 Arb. 3419'  
TD 3420' SD.
- 12/19 " "
- 12/26 " "
- 1941
- 1/2 " "
- 1/9 " "
- 1/16 " "
- 1/23 " "
- 1/30 " "
- 2/6 T.D. 3429' 1000' oil 12 hours.  
2000 acid.

OVER

194  
2/12

Arb. 3419' (Corrected)  
7" - 3294'  
180' of 4" liner 3420'  
T.D. 3429'  
2000 acid.  
Potential 599 bbls., pump.  
36.5 Gravity

3429'

Map No. 64 Sec. 31 Twp. 8 R. 17WWell No. 2 DopitaK. A. Nill

Company

~~FIRST REPORT~~

Contractor

C NW SW

## SECTION PLAT

o			

660 Ft. from N. Line         Ft. from S. Line         Ft. from E. Line660 Ft. from W. Line

DOPITA POOL

Location                                 Rig up                                 Drilling and Remarks:  
Spud - Cable

## RECORD

Cased                  in.,                  ft.Sand                                 Gas                                 Oil                                 Total Depth                                 

## PRODUCTION

1st 24 hrs. Nat.                                 1st 24 hrs. after shot                                 Gas                                  Cu. Ft.Dry Hole                                 Abandoned                                 

Date

JUN 26 1940 19S. J. LEWIS Scout

Map No. 64 Sec. 31 Twp. 8 R. 17W

Well No. 2 Dopita

K. A. Nill Company

Contractor

COMPLETED

SECTION PLAT

0			

C NW SW

660 Ft. from N. Line

\_\_\_\_\_ Ft. from S. Line

\_\_\_\_\_ Ft. from E. Line

660 Ft. from W. Line

DOPITA POOL

Location \_\_\_\_\_

Rig up \_\_\_\_\_

Drilling and Remarks:

*Cr 83419 corrected*

*7" O 3294*

*180' x 4" liner 3420*

*2000 acid*

*Pump. 599 P.D.*

*36 5/8 Gr.*

RECORD

Cased \_\_\_\_\_ in., \_\_\_\_\_ ft.

Sand \_\_\_\_\_

Gas \_\_\_\_\_

Oil \_\_\_\_\_

Total Depth 3429

PRODUCTION

1st 24 hrs. Nat. \_\_\_\_\_

1st 24 hrs. after shot \_\_\_\_\_

Gas \_\_\_\_\_ Cu. Ft.

Dry Hole \_\_\_\_\_

Abandoned \_\_\_\_\_

Date

FEB 12 1941 19

S. J. LEWIS Scout