


Map No. KANSAS Sec. 31 Twp. 8 R. 17W
 Well No. #1 Dopita Farm _____
Phillips pet Company

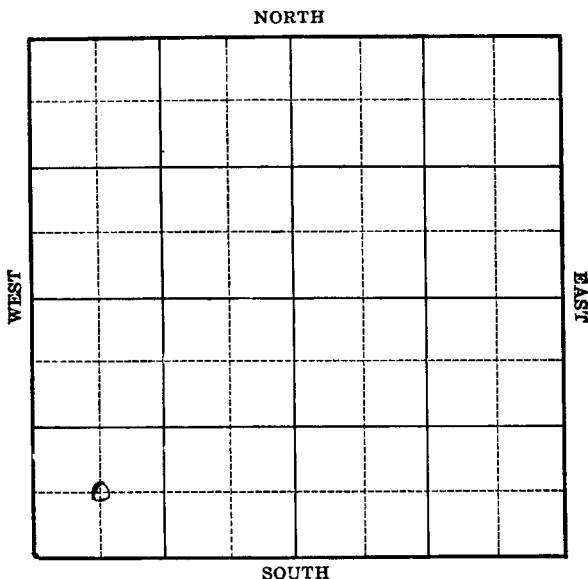

Location _____

Drilling Remarks _____

Rig Up _____

Drilling Remarks _____

RECORD

Cased _____ in. _____ ft.

Sand _____

Gas _____

Oil _____

Total Depth _____

PRODUCTION

1st 24 hrs. Nat. _____

1st 24 hrs. after shot _____

Gas _____ cu. ft.

Dry Hole _____

Abandoned _____


Rooks

Map No. 1000 Sec. 31 Twp. 8 R. 17^WWell No. 1 Hlopeta FarmPhillips Company

Ft. from N. Line

660' Ft. from S. Line

Ft. from E. Line

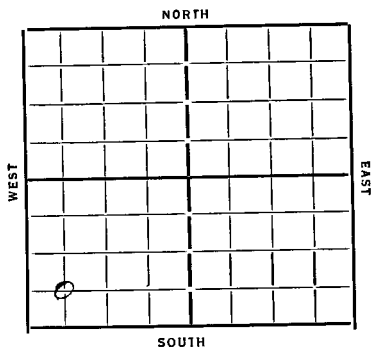660' Ft. from W. LineDate 1934

REPORT

1/3 Location
1/11 cellar
1/17 Bedg
1/24 —
1/31 Spud + 50
2/7 —
2/14 Drly 203
2/23 " 600
3/1 W.R. 15" at 915
3/8 Drly. 1125 15" 894
3/15 —
3/22 Drly 1955
3/29 " 2390 10" 2360 HFW 2375
4/5 " 2670
4/12 " 2930 10" 2406
4/19 Oswald 3152 TD 3165 U.R. 8"
4/26 J.O. 3191-95 S.O. 3205-09
8" 3195 3225-30 3 Bails
water dly 3240
5/3 2477 3246-45 3255 TD
PB to 3217 Bails oil + w.
pu hr 1000 gal acid W.O.F.
- OVER -

5/10 14 oil + 82 water 12 hrs.

5/18 dlq 3283

5/25 8" 3291 TD 3317

5/31 100 Gal acid Swabbed
87 1/2 Bbls 2 1/2 hrs. Water
broke in P B P

6/7 Cum 8" 3291 2 Bbls oil
per hr Recirculating

6/14 114 oil + 11 w. 14 hrs.

6/21 98 oil 11 w 20 hrs.

6/28 — 7/5 —

7/12 Given 3rd acid treatment

7/19 50 oil + 50 w.

7/25 TD 3317 1000 acid
44 oil + 39 water

COMPLETED

Korke


Map No. _____ Sec. 31 Twp. 8 R. 17W
Well No. 1 Aspita Farm _____
Phillips Pet. Company _____

_____ Ft. from N. Line

660 Ft. from S. Line

_____ Ft. from E. Line

660 Ft. from W. Line

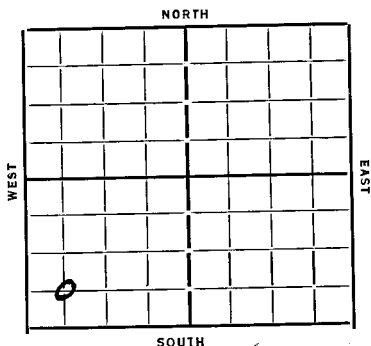

Date 1934

REPORT

8/1 O.T. 3317
7" 3345 C.O.
8/9 T Cong 3380 T Salicous 3409
T.D. 3419 1900' oil 9 hrs
25 Grav.
8/15 Salicous 3409-3419
T.D. 3419 150 bbls
25 Gravity

COMPLETED

Map No. 64 Sec. 31 Twp. 8 R. 17W

Well No. 1-Hopita

J Phillips Company

Contractor

SECTION PLAT

C			

660 Ft. from N. Line

660 Ft. from S. Line

660 Ft. from E. Line

660 Ft. from W. Line

Location _____

Rig up _____

Drilling and Remarks:

1000 and

44 oil

39 water

RECORD

Cased _____ in., _____ ft.

Sand _____

Gas _____

Oil _____

Total Depth 3317

PRODUCTION

1st 24 hrs. Nat. _____

1st 24 hrs. after shot _____

Gas _____ Cu. Ft.

Dry Hole _____

Abandoned _____

Date

7-25-37 19

ORVAL MANNSCHN Scout

Map No. 64 Sec. 31 Twp. 8 R. 17N

Well No. 1-10ajita

Phillips pet. Company

Contractor

C SW SW

SECTION PLAT

Ft. from N. Line

660 Ft. from S. Line

Ft. from E. Line

660 Ft. from W. Line

0			

FIRST REPORTS

Location ✓

Rig up

Drilling and Remarks:

RECORD

Cased.....in.,ft.

Sand.....

Gas.....

Oil.....

Total Depth.....

PRODUCTION

1st 24 hrs. Nat.....

1st 24 hrs. after shot.....

Gas.....Cu. Ft.

Dry Hole.....

Abandoned.....

Date

1-3-34 192

C. W. Mannick Scout

Map No. 64 Sec. 31 Twp. 8 R. 17NWell No. #1- DopitaPhillips pit Company

Contractor

FIRST REPORTS

SECTION PLAT

 Ft. from N. Line660 Ft. from S. Line Ft. from E. Line660 Ft. from W. LineQWR DLocation Rig up

Drilling and Remarks:

OTU 3317" 7 3345C. O.

RECORD

Cased in., ft.Sand Gas No RecordOil Total Depth

PRODUCTION

1st 24 hrs. Nat. 1st 24 hrs. after shot Gas Cu. Ft.Dry Hole Abandoned

Date

8-1-37 19ORVAL MANNSCHIRCK
Scout

Map No. 64 Sec. 31 Twp. 8 R. 17nWell No. 1-DepitaPhillips pet Company

Contractor

COMPLETED

SECTION PLAT

0			

____ Ft. from N. Line

660 Ft. from S. Line

____ Ft. from E. Line

660 Ft. from W. LineQWPN

Location _____

Rig up _____

Drilling and Remarks:

150 fph25 gravity

RECORD

Cased _____ in., _____ ft.

Sand silicious 340g

Gas _____

Oil _____

Total Depth 3419

PRODUCTION

1st 24 hrs. Nat. _____

1st 24 hrs. after shot _____

Gas _____ Cu. Ft.

Dry Hole _____

Abandoned _____

Date

8-15-34ORVAL MANNISCHRECK
Scout