

Graham

KANSAS

SECTION 31 TOWNSHIP 8 RANGE 24W

WELL NO. #2 McKinley

COMPANY Herndon Drlg.

NORTH

SOUTH

WEST

EAST

16

Graham

KANSAS

SEC.	TWP.	R.
31	8	24W

WELL NO.

#2 McKinley

FARM

COMPANY

Herridon Drlg.

CONTRACTOR

Co. Tools

NW Holly


Ft. from N. Line

Ft. from S. Line

Ft. from E. Line

Ft. from W. Line

NE SE SE

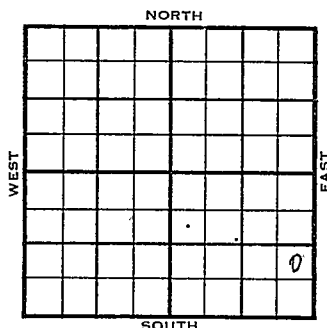

	ELEVATION	REPORT
1956	2419	

4-25	Comm. 4-22-56 8" @ 249 w/175 SD & 249
5-23	DST 3768-94 op 1 hr. rec. 120' wtr. / 64' OCM, 1150/ DST 3865-92 op 30 min. rec. 15' mud, 1200/20". DST 3894-3914 op 1 hr. rec. 45' OCM / 120' 120' fred oil, 650/20". 5 1/2" @ 3948 w/250 44/ 3893-3904, tst 1/2 boph;; tst 1 1/4 boph, no/wtr. P/ 90 bopd, no/wtr.; Grav. 40 Tr. 3730', KC 3745', TD 3948'

COMPLETED

County Graham Elev. _____
 Sec. 31 Twp. 8 Rge. 24W
 Company Herndon Drlg.
 Farm Name McKinley No. 2

TOPS	DEPTH	LOG	DATUM	Loc. in Sec.
Anh.				NE SE SE
Tr.				
H.				
Tr.				
Dg.				
BL.				
L.				
K.C.				Geol.
B.K.C.				Contr.
Ce.				Co. tools
C.				
M.				Pool
M.				NW Holly
K.				
Mz.				
Me.				
V.				
S.				
S.				
A.				
R.				
Pe.				
G.				
T.D.				

FIRST REPORT

APR 25 '56

Date Comm. 4-22-568" @ 249/175 SD @ 249

S YAM

D. M.

County GravettElev. 2419Sec. 31 Twp. 8Rge. 24WCompany Herndon DrillingFarm Name McKinleyNo. 2

TOPS	DEPTH	LOG	DATUM	Loc. in Sec.
Ann				NE SE SE
Tr				
B				
Tr	3730			
D				
Sh				
L				
KC	3745		1326	Geol.
AKC				Contr.
CC				Co. tools
C				
N				
N				Pool
K				NW Holly
N				
V				
S				
S				
A				
R				
R				
E				
TD	3948			

COMPLETE

Date Comm. 4-22-56

MAY 23 1956

8" @ 249/175 SD @ 249 MAY 2 56 DST

3768-94 1hr 120' wth + 64'

OCM 1150/ DST 3865-92

MAY 8 56 30" net 15' Md 1200/20

DST 3894-3915 1hr 45' OCM +

120' Free oil 650/20 MAY 15 56

5 1/2" @ 3948/250 44/3893-3904

1st 1/2 Bopd 12 1st 14 Bopd no/w

P & P Ph P. 90 Bopd no/w gas 40