
Graham **KANSAS**

SECTION 31 TOWNSHIP 8 RANGE 24 W

WELL NO. #5 W. I. Bell

COMPANY Texas Co.

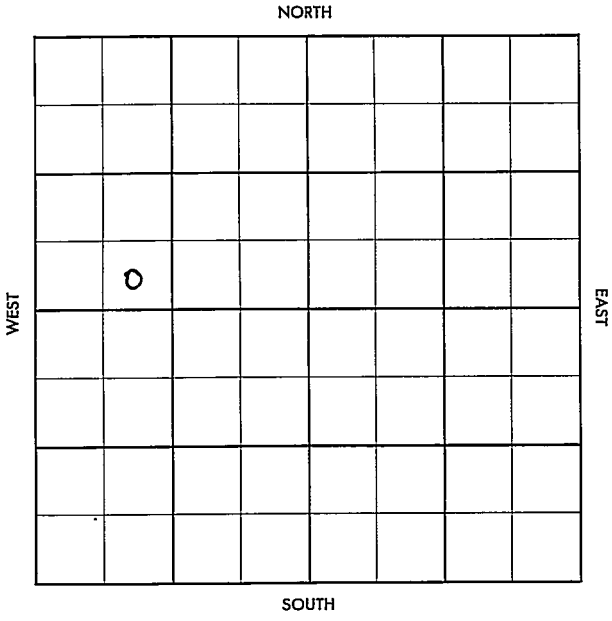

5

FORM 504-3 SUNRAY

Graham KANSAS

SEC.	TWP.	R.
31	8	24W

WELL NO.

#5 W.L. Bell FARM

COMPANY

Texas Company

CONTRACTOR

Powell

W. Holley


_____ Ft. from N. Line

_____ Ft. from S. Line

_____ Ft. from E. Line

_____ Ft. from W. Line

SE SW NW

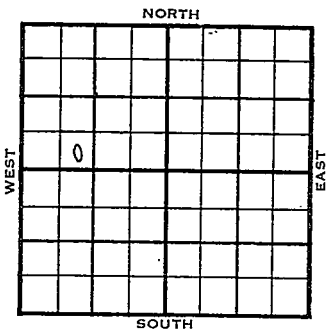

1956	ELEVATION 2482~~2~~ REPORT
1-18	10" @ 318 Drlg. 3790'
2-1	7" @ 4044, 20/ 3990-95, ½ gmw 3 hrs., 2000 A S/ 117 bo, 5 baw 10 hr. P/ 54 bo 8 hrs., Comp. 164 bopd Log tops: Anh. 2175 Tp. 3561 H. 3776 Tr. 3802 L. 3816 TD 4045 **COMPLETED**

DX-78

FORM 513 REV. SUNRAY

County Graham Elev.

Sec. 31 Twp. 8 Rge. 24W

Company Texas Company

Farm Name W. L. Bell No. 5

TOPS	DEPTH	LOG	DATUM
Anh.			
Tp.			
H.			
Tr.			
Dg.			
Bl.			
L.			
K.C.			
B.K.C.			
Ce.			
C.			
M.			
M.			
K.			
Mz.			
Mo.			
V.			
S.			
S.			
A			
R.			
P€.			
G.			
T.D.			

Loc. in Sec. SE SW NW

Geol.

Contr. Powell

Pool W. Holley

JAN 18 '56

0

FIRST REPORT

Date Comm.

10" @ 318 drlg. 3790

Co. Lse. No. Sec. T. R.

FORM 513 REV. SUNRAY

County Graham Elev. 2482 Co.

Sec. 31 Twp. 8 Rge. 24W

Company Texas Company

Farm Name W. L. Bell No. 5


TOPS	DEPTH	LOG	DATUM
Anh.		3175	
T.P.		3561	
H.		3776	
Tr.		3802	
Dg.			
B.L.			
L.		3816	1334
K.C.			
B.K.C.			
Ce.			
C.			
M.			
M.			
K.			
Mz.			
Mo.			
V.			
S.			
S.			
A			
R.			
P€.			
G.			
T.D.	4045		

Loc. in Sec. SE SW NW

Geol.

Contr. Powell Lse.

Pool W. Holley

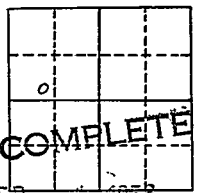

No.

Date Comm. Sec.

10" @ 318 7" @ 4044 20/ 3990-95

½ gmw 3 hr. 2000 A S/ 117 bo T.

5 baw 10 hr. P/ 54 bo 8 hr.

Comp. 164 bopd R.