

Graham

KANSAS

SECTION 31 TOWNSHIP 8 RANGE 21 W

WELL NO. #1 L. L. Bell

COMPANY Texas Co.

NORTH

	0						

WEST

EAST

SOUTH

4

Graham

KANSAS

SEC.

TWP.

R.

31

8

24W

WELL NO.

#4 W.L. Bell

COMPANY

FARM

Texas Company

CONTRACTOR

Powell

W. Holley


Ft. from N. Line

Ft. from S. Line

Ft. from E. Line

Ft. from W. Line

SE NW NW

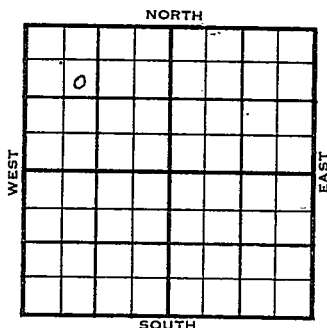

ELEVATION

2474'

REPORT

1955

12-21

MIR

1956

1-26

Comm. 12-22-55

10 3/4" @ 318/210

7" @ 4039/100

16/3982-86

1 3/4 go 3 hrs., 2000 A

S/ 10 bo, 2 baw 6 hrs., 3500 A

S/ 21 bo, 4 hrs.

P/ 22 1/2 bo 8 hrs.,

Comp. 80 bopd

Tp. 3548

3552

Tp. 3767

3772

L. 3806

3810

BKC 4033

4035

TD 4040'

COMPLETED

County Graham Elev. _____
 Sec. 31 Twp. 2 Rgs. 24W
 Company Texas Company
 Farm Name W. L. Bell No. 1

TOPS	DEPTH	LOG	DATUM	Loc. in Sec.
Anh.				SE NW NW
Tr.				
H.				
Tr.				
Dg.				
Bl.				
L.				
K.C.				Geol.
B.K.C.				Contr.
Ce.				Powell
C.				
M.				Pool
M.				W. Holley
K.				
Mz.				
Mq.				
V.				
S.				
S.				
A.				
R.				
PE.				
G.				
TD.				

FIRST REPORT
 DEC 21 '55

Date Comm.

M I R

Co.

Lse.

No.

Sec.

T.

R.

County Graham Elev. 2474
 Sec. 31 Twp. 8 Rge. 24W
 Company Texas Company
 Farm Name W. L. Bell No. 4

TOPS	DEPTH	LOG	DATUM	Loc. in Sec.
Anh.				SE NW NW
Tp.	3548	3552		
H.	3767	3772		
Tr.				
Dg.				
BL.				
L.	3806	3810	1336	Geol.
K.C.				
B.K.C.	4033	4035	1561	Contr.
Ce.				Powell
C.				
M.				Pool
M.				W. Holley
K.				
Mz.				
Ma.				
V.				
S.				
S.				
A.				
R.				
Pe.				
G.				
T.D.	4040			

COMPLETE

Date Comm. 12-22-55

JAN 25 1956

10 3/4" @ 318/210 7" @ 4039/100

16/ 3982-86 1 3/4 go 3 hr. 2000 A

S/ 10 bo 2 baw 6 hr. 3500 A

S/ 21 bo 4 hr. P/ 22 1/2 bo 8 hr.

Comp. 80 bopd