

Graham

KANSAS

SECTION 31 TOWNSHIP 8 RANGE 24 W

WELL NO. #6 W. L. Bell

COMPANY Texas Company

NORTH

WEST								EAST

SOUTH

12

Graham

KANSAS

SEC.	TWP.	R.
31	8	24W

WELL NO.

#6 W.L. Bell

FARM

COMPANY

Texas Company

CONTRACTOR

Powell

W. Holley


Ft. from N. Line

Ft. from S. Line

Ft. from E. Line

Ft. from W. Line

SE NW SW

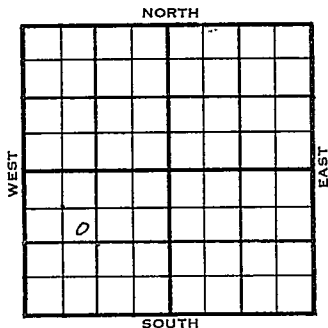

1956

ELEVATION

2454'

REPORT

1-25

Comm. 1-21-56

10" @ 318/210

Drlg. 2270'

3-14

7" @ 4013/100

CO 24/ 3956-63, 18 goph 2 hrs.,
2000 A

S/ 39 bo 10 bw 4 hrs.

P/ 22½ bo 50½ bw 24 hrs.

F/48 bo 89 bw 24 hrs., 26/3957-63, dry,
2000 A

S/ 98 bo, 52 bw 8 hrs.

P/ 58 bo 79 bw 24 hrs.

Comp. 85 bopd, 127 bw

TOPSLOG

Tpl 3527

H. 3743

Tr. 3767

L. 3782

BKC 4004

TD 4014'

COMPLETED

County Graham Elev. _____
 Sec. 31 Twp. 8 Rge. 24W
 Company Texas Company
 Farm Name W. L. Bell No. 6

TOPS/	DEPTH	LOG	DATUM	Loc. in Sec.
Anh.				SE NW SW
TP.				
H.				
Tr.				
Dg.				
Bl.				
L.				Geol.
K.C.				Contr.
B.K.C.				Powell
Ce.				Pool
C.				W. Holley
M.				
M.				
K.				
Mz.				
Mq.				
V.				
S.				
S.				
A.				FIRST REPORT
R.				
PE.				
G.				
TR.				

Date Comm. 1-21-56
10" @ 318/210 drlg. 2270

[Handwritten signature]

County Graham Elev. 2454
 Sec. 37 Twp. 8 Rge. 24W
 Company Texas Company
 Farm Name W. L. Bell No. 6

TOPS	DEPTH	LOG	DATUM	Loc. in Sec.
Anh.				SE NW SW
TP.		3527		
H.		3743		
Tr.		3767		
Dg.				
Bl.				
L.		3782	1328	Geol.
K.C.				
B.K.C.		4004	1550	Contr.
Ce.				Powell
C.				
M.				
M.				Pool
K.				W. Holley
Mz.				
Ma.				
V.				
S.				
S.				
A.				
R.				
PE.				
G.				
T.D.	4014			

COMPLETE

Date Comm. 1-21-56 MAR 14 1956

10" @ 318/210 7" @ 4013/100

CO 24/ 3956-63 18 goph 2 hr.

2 000 A S/ 39 bo 10 bw 4 hr.

P/ 22 $\frac{1}{2}$ bo 50 $\frac{1}{2}$ bw 24 hr.

F/ 48 bo 89 bw 24 hr. 26/ 3957-63

dry 2000 A S/ 98 bo 52 bw 8 hr.

P/ 58 bo 79 bw 24 hr.

Comp. 85 bopd 127 bw