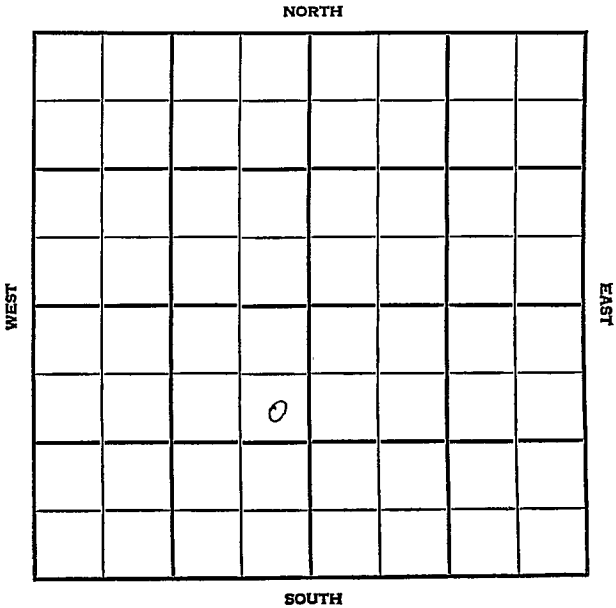


Section 31 Township 8 Range 24WWell No. #13 W. L. BellCompany The Texas Co.

Graham

KANSAS

SEC.

31

TWP.

8

R.

24W

WELL NO.

#13 W.L. Bell

FARM

COMPANY

The Texas Co.

CONTRACTOR

Powell Drlg.

Holley W.


____ FT. FROM N. LINE

____ FT. FROM S. LINE

____ FT. FROM E. LINE

____ FT. FROM W. LINE

SE NE SW

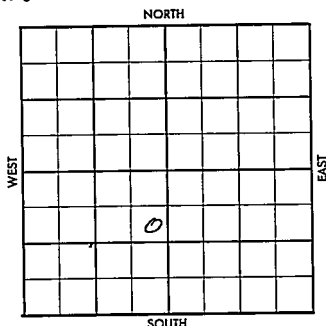

1956

ELEVATION

REPORT

8-29

Comm. 8-27-56
10" @ 320 w/210
Drlg. 320

County Graham Elev. _____
 Sec. 31 Twp. 8 Rge. 24W
 Company The Texas Co.
 Farm Name W. L. Bell No. 13

TOPS	DEPTH	LOG	DATUM	Loc. in Sec.
Anh.				SE NE SW
Tr.				
H.				
Tr.				
Dg.				
Bl.				
L.				Geol. _____
K.C.				Contr. _____
B.K.C.				
Ce.				Powell Drlg.
C.				
M.				Pool
M.				Holley. W.
K.				
Mz.				
Mo.				
V.				
S.				
S.				
A.				
R.				
Pe.				
G.				
T.D.				

FIRST REPORT

AUG 29 '56

Date Comm. 8/27/56
10" @ 320 w/210 Drlg. 320

2001 1 002

County CameronElev. 2289Sec. 31Twp. 8Rge. 24WCompany The Texas Co.Farm Name N. L. BellNo. 13

TOPS	DEPTH	LOG	DATUM	Loc. in Sec.
Anb.				SE NE S.
Tr.				
H.	3720	3772		
Tr.	3794	3797		
Dg.				
BL				
L.	3810	3811		
K.C.				Geol.
B.K.C.				Contr.
Ce.				Powell Drl
C.				Pool
M.				Holley. W.
M.				
K.				
Mz.				
Mo.				
V.				
S.				
S.				
A.				
R.				
PE				
G.				
TD	3988			

COMPLETE

Date Comm. 8/27/56

OCT 10 1956

10" @ 320 W/210 Drlc. 320 SEP 5 '56 173988

SEP 12 '56. 7" @ 3985/100 MICT

Ch 3988 12 Frac & 35 Bo

+ Tr wth 7 hrs & 4 Bophn/w

4 hrs P. 32 Bo. + 2 BW &

hrs P. SEP 19 '56 SEP 26 '56 WO POT

OCT 2 '56

OCT 10 '56

Ph P. 27 Bopd

43 to wth