


Section 31 Township 8 Range 24W
Well No. #14 W.L. Bell
Company The Texas Co.

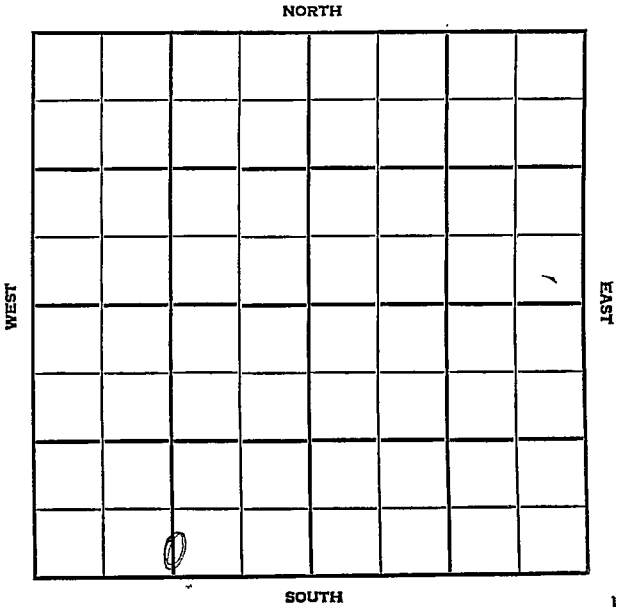

County Graham Elev. _____
Sec. 31 Twp. 8 Rge. 24W
Company The Texas Co.
FarmName W. L. Bell No. 14

TOPS	DEPTH	LOG	DATUM	Loc. in Sec.
Anh.				C/ S/2 S/2 SW
Tr.				
H.				
Tr.				
Dg.				
BL.				
L.				Geol. _____
K.C.				Contr. _____
B.K.C.				Powell Drlg.
Ce.				Pool _____
C.				Holley
M.				
M.				
K.				
Mz.				
Mq.				
V.				
S.				
S.				
A.				
R.				
PE.				
G.				
T.D.				

FIRST REPORT		
00	31	56
0		

Date Comm. spd. 10-29-56
10" @ 312 w/310, WOC

[Handwritten signature]

BY S. VAN

[Handwritten initials]

County Graham Elev. 2484
 Sec. 31 Twp. 8 Rge. 24W
 Company The Texas Co.
 Farm Name W. L. Bell No. 14

TOPS	DEPTH	LOG	DATUM	Loc. in Sec.
Anh.				C/ S/2 S/2 SW
TP.		3557		
H.		3724		
Tr.		3798		
Dg.				
BL.				
L.		3811		
K.C.				Geol.
BKC.				Contr.
Ce.				Powell Drlg.
C.				
M.				Pool
M.				Holley
K.				
Mz.				
Mo.				
V.				
S.				
S.				
A.				
R.				
PE.				
G.				
TD	3991			

NOV 23 56
 COMPLETE

Date Comm. spd. 10-29-56

10" @ 312 w/310, WOC NOV 7 '56 Lost circ

@ 3989 NOV 13 '56 7" @ 3986/100 CO

3991 B Md \$ 59 BO nolw

11 hrs lost 9 hrs \$ 4.24 Boph

nolw T&R NOV 21 '56 P. 30 BO nolw

8 hrs gas 41° Ph P. 90

Boph nolw to