


Section 31 Township 8-S Range 19-W

Well No. #1 Hayden

Company Heathman & Honaker
Barry Pool

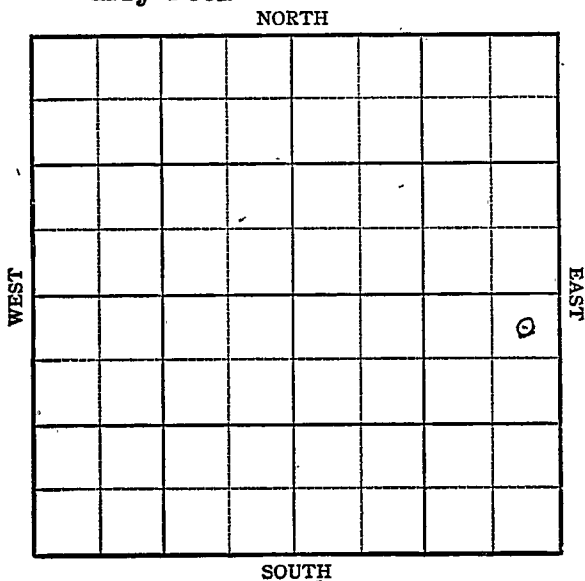

KANSAS

Rooks



Sec. 31 Twp. 8 R. 19W

Well No. #1 Hayden Farm

Heathman & Honaker Company

Barry Pool


330' Ft. from N. Line

_____ Ft. from S. Line

330' Ft. from E. Line

_____ Ft. from W. Line

NE SE

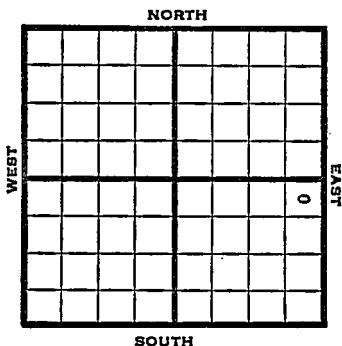

1948

El 2060' REPORT

12/1

Location

12/8

8" @ 219'

Drlg 3110'

12/15

Lansing 3267'

Arbuckle 3513-16'

TD 3516' SO

12/22

5" @ 3513'

TD 3517'

12 shots 3513-16 1000 acid

Swb 90 bbls oil 21 hrs.

12/29

"

"

1/5

Pump 85 bbl oil in 24 hrs

1/12

"

1/19

"

1/26

"

2/2

TD 3517'

Arb 3513'

5" @ 3513'

1000 acid

Pump 22 oil Pot

32⁶ Gr.

Comp

COMPLETED

Map No. _____ Sec. 31 Twp. 8 R. 19W

Well No. 1 Hayden

Heathman & Honaker Company

FIRST REPORT

Contractor

NE SE

SECTION PLAT

330 Ft. from N. Line

_____ Ft. from S. Line

330 Ft. from E. Line

_____ Ft. from W. Line

Rooks County

Location X

Rig up _____

Drilling and Remarks: _____

RECORD

Cased _____ in., _____ ft.

Sand _____

Gas _____

Oil _____

Total Depth _____

PRODUCTION

1st 24 hrs. Nat. _____

1st 24 hrs. after shot _____

Gas _____ Cu. Ft.

Dry Hole _____

Abandoned _____

Date

DEC 1 1948 in _____

S. J. LEWIS Scout

Kansas

Map No. 65 Sec. 31 Twp. 8 R. 19W

Well No. 1 Hayden

Heathman & Honaker Company

COMPLETE

Contractor

NE SE

E. 2060

SECTION PLAT

			o

330 Ft. from N. Line

 Ft. from S. Line

330 Ft. from E. Line

 Ft. from W. Line

Rooks County

RECORD

Location

Cased in., ft.

Rig up

Sand

Drilling and Remarks:

Gas

Core 8 8513

Oil

5" 8513

Total Depth 3572

1000 acid

Pump 122 oil Prod

PRODUCTION

1st 24 hrs. Nat.

1st 24 hrs. after shot

Gas Cu. Ft.

Dry Hole

Abandoned

32 1/2 cu

Date

FEB 2 1949 19..

S. J. LEWIS

Scout